WATER WELL PLUGGING RECORD **Form WWC-5P** **KSA 82a-1212** **ID NO.**

1 **LOCATION OF WATER WELL:** County: Kearny	Fraction NW ¼ NW ¼ NW ¼	Section Number 21	Township Number 23	Range Number 35 E/W

Distance and direction from nearest town or city street address of well if located within city?

2 WATER WELL OWNER: Huff Puff Park LLC

RR#, St. Address, Box #: 2150 ROAD 220

City, State ZIP Code: Deerfield KS 67938

Global Positioning Systems (decimal degrees, min. of 4 digits
Latitude:
Longitude:
Elevation:
Datum:
Data Collection Method:

3 MARK WELL'S LOCATION WITH AN "X" IN SECTION BOX:

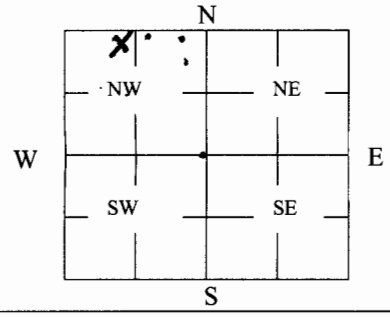

4 DEPTH OF WELL 65 ft Approx ft.

WELL'S STATIC WATER LEVEL below that ft Approx 14 ft

WELL WAS USED AS:

1 Domestic
2 Irrigation
3 Feedlot
4 Industrial
5 Public Water Supply
6 Oil Field Water Supply
7 Domestic (Lawn & Garden)
8 Air Conditioning
9 Dewatering
10 Monitoring
11 Injection Well
12 Other KDHE screw up

Was a chemical/bacteriological sample submitted to Department? Yes____ No X

5 TYPE OF BLANK CASING USED:

1 Steel
2 PVC
3 RMP (SR)
4 ABS
5 Wrought
6 Asbestos-Cement
7 Fiberglass
8 Concrete Tile
9 Other (Specify below)

Blank casing diameter 4 in. Was casing pulled? Yes ____ No X If yes, how much ____

Casing height above or below land surface 60 in.

6 GROUT PLUG MATERIAL: 1 Neat cement 2 Cement grout 3 Bentonite 4 Other subsoil in bottom compacted

Grout Plug Intervals: From ____ ft. to ____ ft., From ____ ft. to ____ ft., From ____ to ____ ft.

What is the nearest source of possible contamination:

1 Septic tank
2 Sewer lines
3 Watertight sewer lines
4 Lateral lines
5 Cess pool
6 Seepage pit
7 Pit privy
8 Sewage lagoon
9 Feedyard
10 Livestock pens
11 Fuel Storage
12 Fertilizer storage
13 Insecticide storage
14 Abandoned water well
15 Oil well/Gas well
16 Other (specify below)

Direction from well? S
How many feet? 405 ft

FROM	TO	PLUGGING MATERIALS	FROM	TO	PLUGGING MATERIALS
0	5	Dirt			
5	8	Cement			
8	65	Subsoil			
		~~Silt~~			

7 CONTRACTOR'S OR LANDOWNER'S CERTIFICATION: This water well was plugged under my jurisdiction and was completed on (mo/day/year) 5/18/11 and this record is true to the best of my knowledge and belief. Kansas Water Well Contractor's License No. N/A. This Water Well Record was completed on (mo/day/year) 5/22/11 under the business name of Huff Puff Park LLC by (signature) [signature].

INSTRUCTIONS: Use typewriter or ballpoint pen. Please press firmly and print clearly. Please fill in blanks, underline or circle the correct answers. Send top three copies to Kansas Department of Health and Environment, Bureau of Water, Geology Section, 1000 SW Jackson St., Ste. 420, Topeka, Kansas 66612-1367. Telephone: 785/296-5522. Send one to Water Well Owner and retain one for your records. Visit us at http://www.kdheks.gov/geo/waterwells.