

**WATER WELL RECORD**

**Form WWC-5**

Division of Water Resources App. No.


21,792

<b>1 LOCATION OF WATER WELL:</b> County: KEARNY	Fraction ¼ SW ¼ SE ¼ NE ¼	Section Number 9	Township No. T 23 S	Range Number R 35 <input type="checkbox"/> E <input checked="" type="checkbox"/> W
--	------------------------------	---------------------	------------------------	---

Street/Rural Address of Well Location; if unknown, distance & direction from nearest town or intersection: If at owner's address, check here .  
DEERFIELD RD 180, WEST TO ROAD Z, N 5 MILES TO RD 230 WEST 1 MILE TO ROAD Y, 1/2 MILE N.

**Global Positioning System (GPS) information:**  
Latitude: .38,06854..... (in decimal degrees)  
Longitude: 101.16147..... (in decimal degrees)  
Elevation: .....  
Datum:  WGS 84,  NAD 83,  NAD 27  
Collection Method:  
 GPS unit (Make/Model: .....)  
 Digital Map/Photo,  Topographic Map,  Land Survey  
Est. Accuracy:  <3 m,  3-5 m,  5-15 m,  >15 m

**2 WATER WELL OWNER:** MILLER FARMS INC  
RR#, Street Address, Box #: 2413 ROAD Y  
City, State, ZIP Code : DEERFIELD, KS 67838

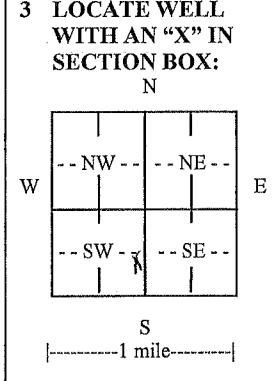

**4 DEPTH OF COMPLETED WELL** 336..... ft.  
Depth(s) Groundwater Encountered (1)..... ft. (2)..... ft. (3)..... ft.  
WELL'S STATIC WATER LEVEL 154.....ft. below land surface measured on mo/day/yr. 6-29-11.....  
Pump test data: Well water was 226.....ft. after 4..... hours pumping 1003..... gpm  
EST. YIELD.....gpm. Well water was.....ft. after..... hours pumping..... gpm  
Bore Hole Diameter 16.....in. to 336.....ft., and.....in. to.....ft.  
WELL WATER TO BE USED AS:  Public water supply  Geothermal  Injection well  
 Domestic  Feedlot  Oil field water supply  Dewatering  Other (Specify below)  
 Irrigation  Industrial  Domestic-lawn & garden  Monitoring well .....  
Was a chemical/bacteriological sample submitted to Department?  Yes  No  
If yes, mo/day/yr sample was submitted.....  
Water well disinfected?  Yes  No

**5 TYPE OF CASING USED:**  Steel  PVC  Other .....  
CASING JOINTS:  Glued  Clamped  Welded  Threaded  
Casing diameter 24..... in. to 270..... ft., Diameter ..... in. to ..... ft., Diameter ..... in. to ..... ft.  
Casing height above land surface 12..... in., Weight 36.95.....lbs./ft., Wall thickness or gauge No. 219.....  
TYPE OF SCREEN OR PERFORATION MATERIAL:  
 Steel  Stainless Steel  PVC  Other (Specify) .....  
 Brass  Galvanized Steel  None used (open hole)  
SCREEN OR PERFORATION OPENINGS ARE:  
 Continuous slot  Mill slot  Gauze wrapped  Torch cut  Drilled holes  None (open hole)  
 Louvered shutter  Key punched  Wire wrapped  Saw cut  Other (specify) .....  
SCREEN-PERFORATED INTERVALS: From 171..... ft. to 261..... ft., From 286..... ft. to 316..... ft.  
From..... ft. to..... ft., From..... ft. to..... ft.  
GRAVEL PACK INTERVALS: From 20..... ft. to 336..... ft., From..... ft. to..... ft.  
From..... ft. to..... ft., From..... ft. to..... ft.

**6 GROUT MATERIAL:**  Neat cement  Cement grout  Bentonite  Other .....  
Grout Intervals: From 0..... ft. to 20..... ft., From..... ft. to..... ft., From..... ft. to..... ft.  
What is the nearest source of possible contamination:  
 Septic tank  Lateral lines  Pit privy  Livestock pens  Insecticide storage  Other (specify below)  
 Sewer lines  Cesspool  Sewage lagoon  Fuel storage  Abandoned water well  
 Watertight sewer lines  Seepage pit  Feedyard  Fertilizer storage  Oil well/gas well .....  
Direction from well East..... Distance from well 173.....

FROM	TO	LITHOLOGIC LOG	FROM	TO	LITHO. LOG (cont.) or PLUGGING INTERVALS
0	2	TOP SOIL	132	146	SAND FINE TO MED COURSE
2	19	BROWN SANDY CLAY	146	164	BROWN SANDY CLAY
19	25	SAND FINE TO MED	164	172	SAND FINE TO MED COURSE W/ CLAY STR
25	49	BRN SANDY CLAY W/ FEW SM SAND B	172	200	SAND FINE TO MED COURSE
49	60	BROWN CLAY	200	220	SAND FINE TO MED COURSE SM GRAVEL
60	70	SAND FINE TO MED COURSE SM GRA	220	230	SAND FINE TO MED W/COUPLE CLAY STRI
70	99	SAND FINE TO MED W/ FEW CLY STRI	230	245	FINE SAND W/ SOME CLAY STRINGERS
99	107	BROWN SANDY CLAY	245	256	BROWN SANDY CLAY
107	126	SAND FINE TO MED COURSE FEW SM	256	261	SAND FINE TO MED COURSE
126	132	BROWN SANDY CLAY	261	283	BROWN CLAY STICKY

**7 CONTRACTOR'S OR LANDOWNER'S CERTIFICATION:** This water well was  constructed,  reconstructed, or  plugged under my jurisdiction and was completed on (mo/day/year) 6-27-11..... and this record is true to the best of my knowledge and belief. Kansas Water Well Contractor's License No. 145..... This Water Well Record was completed on (mo/day/year) 9-9-11..... under the business name of HYDRO RESOURCES..... by (signature) *Daniel J. Richman*

**INSTRUCTIONS:** Use typewriter or ball point pen. PLEASE PRESS FIRMLY and PRINT clearly. Please fill in blanks and check the correct answers. Send three copies (white, blue, pink) to Kansas Department of Health and Environment, Bureau of Water, Geology Section, 1000 SW Jackson St., Suite 420, Topeka, Kansas 66612-1367. Telephone 785-296-5522. Send one copy to WATER WELL OWNER and retain one for your records. Include fee of \$5.00 for each constructed well. Visit us at <http://www.kdheks.gov/waterwell/index.html>.

**WATER WELL RECORD**

**Form WWC-5**

Division of Water Resources App. No.


21,792

<b>1 LOCATION OF WATER WELL:</b> County: KEARNY	Fraction ¼ SW ¼ SE ¼ NE ¼	Section Number 9	Township No. T 23 S	Range Number R 35 <input type="checkbox"/> E <input checked="" type="checkbox"/> W
--	------------------------------	---------------------	------------------------	---

Street/Rural Address of Well Location; if unknown, distance & direction from nearest town or intersection: If at owner's address, check here .  
DEERFIELD RD 180, WEST TO ROAD Z, N 5 MILES TO RD 230 WEST 1 MILE TO ROAD Y, 1/2 MILE N.

**Global Positioning System (GPS) information:**  
 Latitude: .38,06854..... (in decimal degrees)  
 Longitude: 101.16147..... (in decimal degrees)  
 Elevation: .....  
 Datum:  WGS 84,  NAD 83,  NAD 27  
 Collection Method:  
 GPS unit (Make/Model: .....)  
 Digital Map/Photo,  Topographic Map,  Land Survey  
 Est. Accuracy:  <3 m,  3-5 m,  5-15 m,  >15 m

**2 WATER WELL OWNER:** MILLER FARMS INC  
 RR#, Street Address, Box #: 2413 ROAD Y  
 City, State, ZIP Code : DEERFIELD, KS 67838

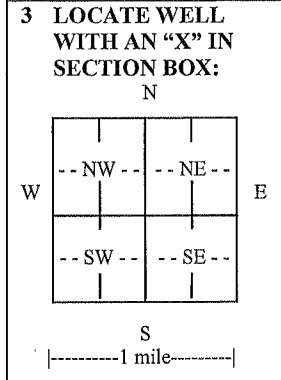

**4 DEPTH OF COMPLETED WELL** 336..... ft.

Depth(s) Groundwater Encountered (1)..... ft. (2)..... ft. (3)..... ft.

WELL'S STATIC WATER LEVEL 145..... ft. below land surface measured on mo/day/yr. 8-31-10.....

Pump test data: Well water was 226..... ft. after 4..... hours pumping 1003..... gpm

EST. YIELD..... gpm. Well water was..... ft. after..... hours pumping..... gpm

Bore Hole Diameter 24..... in. to 336..... ft., and..... in. to..... ft.

WELL WATER TO BE USED AS:  Public water supply  Geothermal  Injection well  
 Domestic  Feedlot  Oil field water supply  Dewatering  Other (Specify below)  
 Irrigation  Industrial  Domestic-lawn & garden  Monitoring well .....

Was a chemical/bacteriological sample submitted to Department?  Yes  No

If yes, mo/day/yr sample was submitted.....

Water well disinfected?  Yes  No

**5 TYPE OF CASING USED:**  Steel  PVC  Other .....

CASING JOINTS:  Glued  Clamped  Welded  Threaded

Casing diameter 24..... in. to 270..... ft., Diameter..... in. to..... ft., Diameter..... in. to..... ft.

Casing height above land surface 12..... in., Weight 36.95..... lbs./ft., Wall thickness or gauge No. 219.....

TYPE OF SCREEN OR PERFORATION MATERIAL:  
 Steel  Stainless Steel  PVC  Other (Specify) .....  
 Brass  Galvanized Steel  None used (open hole)

SCREEN OR PERFORATION OPENINGS ARE:  
 Continuous slot  Mill slot  Gauze wrapped  Torch cut  Drilled holes  None (open hole)  
 Louvered shutter  Key punched  Wire wrapped  Saw cut  Other (specify) .....

SCREEN-PERFORATED INTERVALS: From 171..... ft. to 261..... ft., From 286..... ft. to 316..... ft.  
 From..... ft. to..... ft., From..... ft. to..... ft.

GRAVEL PACK INTERVALS: From 20..... ft. to 336..... ft., From..... ft. to..... ft.  
 From..... ft. to..... ft., From..... ft. to..... ft.

**6 GROUT MATERIAL:**  Neat cement  Cement grout  Bentonite  Other .....

Grout Intervals: From 0..... ft. to 20..... ft., From..... ft. to..... ft., From..... ft. to..... ft.

What is the nearest source of possible contamination:  
 Septic tank  Lateral lines  Pit privy  Livestock pens  Insecticide storage  Other (specify below)  
 Sewer lines  Cesspool  Sewage lagoon  Fuel storage  Abandoned water well  
 Watertight sewer lines  Seepage pit  Feedyard  Fertilizer storage  Oil well/gas well .....

Direction from well..... Distance from well.....

FROM	TO	LITHOLOGIC LOG	FROM	TO	LITHO. LOG (cont.) or PLUGGING INTERVALS
283	302	SAND FINE TO MED W/BRN & TAN RK			
302	316	SAND FINE TO MD W/ BRN & TN RK			
316	318	YELLOW SANDSTONE			
318	330	BLACK SHALE			

**7 CONTRACTOR'S OR LANDOWNER'S CERTIFICATION:** This water well was  constructed,  reconstructed, or  plugged under my jurisdiction and was completed on (mo/day/year) 6-27-11..... and this record is true to the best of my knowledge and belief. Kansas Water Well Contractor's License No. 145..... This Water Well Record was completed on (mo/day/year) 9-9-11..... under the business name of HYDRO RESOURCES..... by (signature).....

**INSTRUCTIONS:** Use typewriter or ball point pen. PLEASE PRESS FIRMLY and PRINT clearly. Please fill in blanks and check the correct answers. Send three copies (white, blue, pink) to Kansas Department of Health and Environment, Bureau of Water, Geology Section, 1000 SW Jackson St., Suite 420, Topeka, Kansas 66612-1367. Telephone 785-296-5522. Send one copy to WATER WELL OWNER and retain one for your records. Include fee of \$5.00 for each constructed well. Visit us at <http://www.kdheks.gov/waterwell/index.html>.