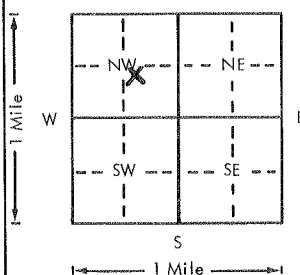


USE TYPEWRITER OR BALL POINT PEN-PRESS FIRMLY, PRINT CLEARLY.

WATER WELL RECORD  
KSA 82a-1201-1215

Kansas Department of Health and Environment-Division of Environment  
(Water well Contractors)  
Topeka, Kansas 66620

1. Location of well:	County <b>Kearny</b>	Fraction <b>NW 1/4 SE 1/4 NW 1/4</b>	Section number <b>22</b>	Township number <b>T 23 S R 35</b>	Range number <b>35</b>	
2. Distance and direction from nearest town or city: <b>4 North and</b> Street address of well location if in city: <b>1 West of Deerfield, Kansas</b>			3. Owner of well: <b>Scott Clark, Jr.</b> R.R. or street: <b>412 First National Center</b> City, state, zip code: <b>Hutchinson, Kansas 67501</b>			
4. Locate with "X" in section below: <div style="text-align: center;">  </div>			Sketch map: <b>70' E-SE of old well near center of NW 1/4, Sec. 22, T23S, R35W, Kearny County, Kansas</b>			
5. Type and color of material			From	To		
Top soil			0	4		
Tan clay			4	42		
Tan clay with fine sand streaks			42	78		
Fine sand			78	82		
Tan clay with fine sand streaks			82	98		
Fine sand			98	112		
Tan clay with fine sand streaks			112	152		
Fine sand			152	189		
Tan clay with fine sand streaks			189	202		
Fine sand			202	222		
Fine to medium sand			222	252		
Tan clay with fine sand streaks			252	262		
Fine to medium sand			262	278		
Fine sand with clay streaks			278	352		
Fine sand			352	362		
Tan clay			362	372		
Fine sand			372	376		
Shale			376	390		
(Use a second sheet if needed)						
18. Elevation:  Topography: ___ Hill ___ Slope <input checked="" type="checkbox"/> Upland ___ Valley	19. Remarks: <b>The existing well, which was abandoned due to the fact that the casing had collapsed, was filled with fine sand and a strong chlorine solution up to a point 5' below ground level. Then, a 2' concrete plug was poured and the casing cut off at a point 3' below ground level.</b>			20. Water well contractor's certification: This well was drilled under my jurisdiction and this report is true to the best of my knowledge and belief. <b>Layne-Western Co., Inc. 102</b> Business name License No. Address <b>Garden City, Ks. 67846</b> Signed <i>[Signature]</i> Date <b>7 Aug 78</b> Authorized representative		

Forward the white, blue and pink copies to the Department of Health and Environment

Form WWC-5

22  
 35  
 W  
 22  
 NW  
 Sec  
 1/4  
 1/4  
 1/4