

WATER WELL RECORD

Form WWC-5


Division of Water Resources App. No.

2500

1 LOCATION OF WATER WELL: County: Kearny Fraction 1/4 NW 1/4 NW 1/4 SE 1/4 Section Number 1 Township No. T 23 S Range Number R 35

Street/Rural Address of Well Location; if unknown, distance & direction from nearest town or intersection: 6.25 miles north, 1 mile east of Deerfield, Ks. Global Positioning System (GPS) information: Latitude: 38.0821606 Longitude: 101.1102069

2 WATER WELL OWNER: ACU inc. RR#, Street Address, Box #: 13195 west 7 mile rd. City, State, ZIP Code : Deerfield, Ks. 67838

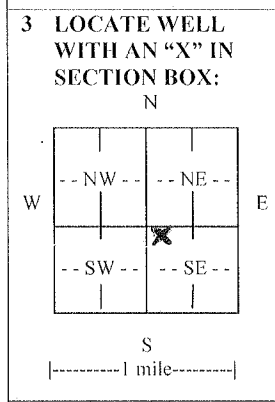

3 LOCATE WELL WITH AN 'X' IN SECTION BOX: 4 DEPTH OF COMPLETED WELL: Depth(s) Groundwater Encountered (1) 190 ft. WELL'S STATIC WATER LEVEL 190 ft. below land surface measured on mo/day/yr. Pump test data: Well water was ... EST. YIELD ... Bore Hole Diameter ... WELL WATER TO BE USED AS: Irrigation checked. Was a chemical/bacteriological sample submitted to Department? No. Water well disinfected? Yes.

5 TYPE OF CASING USED: Steel checked. CASING JOINTS: Glued, Clamped, Welded, Threaded. Casing diameter .16 in. to .388 in. Casing height above land surface .12 in. TYPE OF SCREEN OR PERFORATION MATERIAL: Steel checked. SCREEN OR PERFORATION OPENINGS ARE: Continuous slot checked. SCREEN-PERFORATED INTERVALS: From 243 ft. to 253 ft. GRAVEL PACK INTERVALS: From 0 ft. to 4 ft.

6 GROUT MATERIAL: Cement grout checked, Bentonite checked. Grout Intervals: From ... ft. to ... ft. What is the nearest source of possible contamination: Oil well/gas well checked. Direction from well NW. Distance from well 800'.

Table with 6 columns: FROM, TO, LITHOLOGIC LOG, FROM, TO, LITHO. LOG (cont.) or PLUGGING INTERVALS. Contains log entries such as 'weld 2" vent/access at 4' below land surface, grouted with cement'.

7 CONTRACTOR'S OR LANDOWNER'S CERTIFICATION: This water well was reconstructed, or plugged under my jurisdiction and was completed on (mo/day/year) 4-24-14. Kansas Water Well Contractor's License No. 874. This Water Well Record was completed on (mo/day/year) 4-24-14 under the business name of Kansas Well-cam by (signature) [Signature]

INSTRUCTIONS: Use typewriter or ball point pen. PLEASE PRESS FIRMLY and PRINT clearly. Please fill in blanks and check the correct answers. Send one copy to Kansas Department of Health and Environment, Bureau of Water, Geology Section, 1000 SW Jackson St., Suite 420, Topeka, Kansas 66612-1367. Telephone 785-296-5524. Send one copy to WATER WELL OWNER and retain one for your records. Include fee of \$5.00 for each constructed well. Visit us at http://www.kdheks.gov/waterwell/index.html