

WATER WELL PLUGGING RECORD Form WWC-5P

KSA 82a-1212

ID NO.

16674

1 **LOCATION OF WATER WELL:** Fraction ¼ SW ¼ NW ¼ NW ¼ Section Number 16 Township Number T 23 S Range Number 35 E W
 County: KEARNY


Street/Rural Address of Well Location, if unknown, distance & direction from nearest town or intersection: If at owner's address, check here From the Intersection of 230 Road & X Rd

Approx. 2/10 mile South 60' East into field

Global Positioning Systems (GPS) information:
 Latitude: 38.05819 N (in decimal degrees)
 Longitude: -100.17590 (in decimal degrees)
 Elevation: _____
 Datum: WGS84, NAD83, NAD27
 Collection Method: _____
 GPS unit (Make/Model) Garmin eTrex 10
 Digital Map/Photo, Topographic Map, Land Survey
 Est. Accuracy: <3 m, 3-5 m, 5-15 m, >15 m

2 **WATER WELL OWNER:** Green Acre Farms Inc.
 RR#, St. Address, Box #: 1939 Road Z
 City, State ZIP Code: Deerfield Ks., 67838

3 **MARK WELL'S LOCATION WITH AN "X" IN SECTION BOX:**

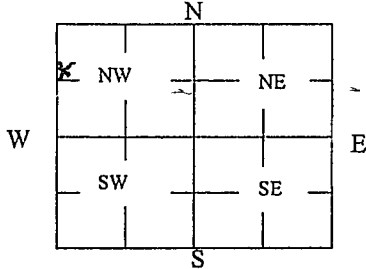

4 **DEPTH OF WELL** 252' ft.
WELL'S STATIC WATER LEVEL 192' ft

WELL WAS USED AS:

- Domestic
- Public Water Supply
- Dewatering
- Irrigation
- Oil Field Water Supply
- Monitoring
- Feedlot
- Domestic (Lawn & Garden)
- Injection Well
- Industrial
- Air Conditioning
- Other _____

Was a chemical/bacteriological sample submitted to Department? Yes No

5 **TYPE OF BLANK CASING USED:**

- Steel
- RMP (SR)
- Wrought
- Fiberglass
- Other (Specify below) _____
- PVC
- ABS
- Asbestos-Cement
- Concrete Tile

Blank casing diameter 16" in. Was casing pulled? Yes No If yes, how much 60"
 Casing height above or below land surface Below 60" in.

6 **GROUT PLUG MATERIAL:** Neat cement Cement grout Bentonite Other _____

Grout Plug Intervals: From 10' ft. to 5' ft., From _____ ft. to _____ ft., From _____ to _____ ft.

What is the nearest source of possible contamination:

- Septic tank
- Seepage pit
- Fuel Storage
- Other (specify below) _____
- Sewer lines
- Pit privy
- Fertilizer storage
- None Observed
- Watertight sewer lines
- Sewage lagoon
- Insecticide storage
- Lateral lines
- Feedyard
- Abandoned water well
- Direction from well? _____
- Cess pool
- Livestock pens
- Oil well/Gas well
- How many feet? _____

FROM	TO	PLUGGING MATERIALS	FROM	TO	PLUGGING MATERIALS
252'	192'	Chlorinated Road Sand	192'	10'	Oversized Rock w/Clay Chunks
10'	5'	3,000 PSI Concrete	5'	0'	Cut Off Casing & Back filled

7 **CONTRACTOR'S OR LANDOWNER'S CERTIFICATION:** This water well was plugged under my jurisdiction and was completed on (mo/day/year) 11-18-2021 and this record is true to the best of my knowledge and belief Kansas Water Well Contractor's License No. 145. This Water Well Record was completed on (mo/day/year) 11-19-2021 under the business name of Hydro Resources Mid Continent by (signature) Gary Clepper

INSTRUCTIONS: Use typewriter or ballpoint pen. Please press firmly and print clearly. Please fill in blanks, underline or circle the correct answers. Send top three copies to Kansas Department of Health and Environment, Bureau of Water, Geology Section, 1000 SW Jackson St., Ste. 420, Topeka, Kansas 66612-1367. Telephone: 785/296-5524. Send one to Water Well Owner and retain one for your records. Visit us at <http://www.kdheks.gov/waterwell/index.html>

Check one: White Copy Blue Copy Pink Copy