


1	LOCATION OF WATER WELL:	Fraction <i>SW NE NE</i> <small>¼ ¼ ¼</small>	Section Number <i>25</i>	Township Number <i>23</i>	Range Number <i>36</i>
---	-------------------------	---	-----------------------------	------------------------------	---------------------------

County: *Kearny*

Distance and direction from nearest town or city street address of well if located within city?

2	WATER WELL OWNER: <i>Bill Simshauser</i>	Board of Agriculture, Division of Water Resources
	RR #, St. Address, Box #: <i>HRC 3 Box 37</i>	Application Number:
	City, State, ZIP Code: <i>Lakin, KS 67860</i>	

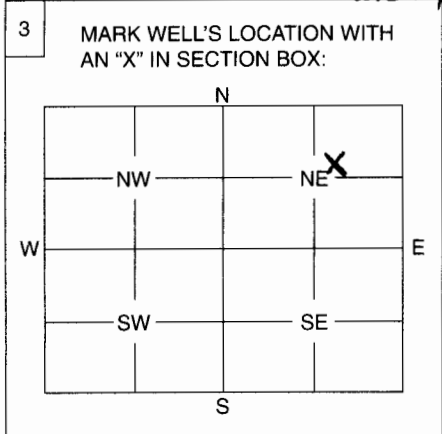

4 DEPTH OF WELL *132* ft.

WELL'S STATIC WATER LEVEL *112* ft.

WELL WAS USED AS:

<input checked="" type="checkbox"/> Domestic	5 Public Water Supply	9 Dewatering
<input type="checkbox"/> Irrigation	6 Oil Field Water Supply	10 Monitoring Well
<input type="checkbox"/> Feedlot	7 Domestic (Lawn & Garden)	11 Injection Well
<input type="checkbox"/> Industrial	8 Air Conditioning	12 Other

Was a chemical / bacteriological sample submitted to Department? Yes No

If yes, mo/day/yr sample was submitted

Water Well Disinfected: Yes .. No

5 TYPE OF BLANK CASING USED:

1 Steel	3 RMP (SR)	5 Wrought	7 Fiberglass	9 Other (Specify below)
<input checked="" type="checkbox"/> PVC	4 ABS	6 Asbestos-Cement	8 Concrete Tile	

Blank casing diameter *10* in. Was casing pulled? Yes No .. If yes, how much

Casing height above or below and surface *3 ft* in.

6 GROUT PLUG MATERIAL: 1 Neat cement 2 Cement grout Bentonite 4 Other

Grout Plug Intervals: From *3* ft. to *20* ft., From ft. to ft., From to ft.

What is the nearest source of possible contamination: *none*

1 Septic tank	6 Seepage pit	11 Fuel storage	16 Other (specify below)
2 Sewer lines	7 Pit privy	12 Fertilizer storage	
3 Watertight sewer lines	8 Sewage lagoon	13 Insecticide storage	
4 Lateral lines	9 Feedyard	14 Abandoned water well	
5 Cess pool	10 Livestock pens	15 Oil well/Gas well	

Direction from well? How many feet?

FROM	TO	PLUGGING MATERIALS
<i>110</i>	<i>132</i>	<i>1/2 yd. washed sand + gravel</i>
<i>20</i>	<i>110</i>	<i>1 yd. " " " , clay mixed</i>
<i>3</i>	<i>20</i>	<i>200 lbs. bentonite</i>
<i>0</i>	<i>3</i>	<i>top soil</i>

7 CONTRACTOR'S OF LANDOWNER'S CERTIFICATION: This water well was plugged under my jurisdiction and was completed on (mo/day/year) *7-5-07* and this record is true to the best of my knowledge and belief. Kansas Water Well Contractor's License No. *532* This Water Well Record was completed on (mo/day/year) *7-17-07* under the business name of *Midwest Well & Pump, Inc.* by (signature) *John M. Saubert*

INSTRUCTIONS: Use typewriter or ball point pen. Please press firmly and print clearly. Please fill in blanks, underline or circle the correct answers. Send top three copies to Kansas Department of Health and Environment, Bureau of Water, Geology Section, 1000 SW Jackson St., Ste. 420, Topeka, Kansas 66612-1367. Telephone: 785/296-5522. Send one to Water Well Owner and retain one for your records.