

**WATER WELL RECORD**

**Form WWC-5**

Division of Water Resources App. No.


9,002

<b>1 LOCATION OF WATER WELL:</b> County: Kearny	Fraction ¼ NW ¼ NW ¼ NW ¼	Section Number 32	Township No. T 23 S	Range Number R 36 <input type="checkbox"/> E <input checked="" type="checkbox"/> W
--	------------------------------	----------------------	------------------------	---

Street/Rural Address of Well Location; if unknown, distance & direction from nearest town or intersection: If at owner's address, check here .  
LAKIN- HWY 25 TO ROAD 200 w 2 MILES

**Global Positioning System (GPS) information:**  
 Latitude: ...N 38.01627..... (in decimal degrees)  
 Longitude: W101.30316..... (in decimal degrees)  
 Elevation: .....  
 Datum:  WGS 84,  NAD 83,  NAD 27  
 Collection Method:  
 GPS unit (Make/Model: .....)  
 Digital Map/Photo,  Topographic Map,  Land Survey  
 Est. Accuracy:  <3 m,  3-5 m,  5-15 m,  >15 m

**2 WATER WELL OWNER:** KARIN GLASS & NORMAN HAMPTN  
 RR#, Street Address, Box #: PO BOX 192  
 City, State, ZIP Code : BRADFORDWOODS, PA 15015

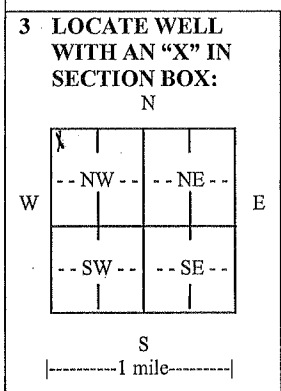

**4 DEPTH OF COMPLETED WELL** 316..... ft.

Depth(s) Groundwater Encountered (1)..... ft. (2)..... ft. (3)..... ft.

WELL'S STATIC WATER LEVEL 255..... ft. below land surface measured on mo/day/yr. 6:28:11.....

Pump test data: Well water was 291..... ft. after 4..... hours pumping 252..... gpm

EST. YIELD..... gpm. Well water was..... ft. after..... hours pumping..... gpm

Bore Hole Diameter 24..... in. to 316..... ft., and..... in. to..... ft.

WELL WATER TO BE USED AS:  Public water supply  Geothermal  Injection well  
 Domestic  Feedlot  Oil field water supply  Dewatering  Other (Specify below)  
 Irrigation  Industrial  Domestic-lawn & garden  Monitoring well .....

Was a chemical/bacteriological sample submitted to Department?  Yes  No

If yes, mo/day/yr sample was submitted.....

Water well disinfected?  Yes  No

**5 TYPE OF CASING USED:**  Steel  PVC  Other .....

CASING JOINTS:  Glued  Clamped  Welded  Threaded

Casing diameter .16..... in. to .316..... ft., Diameter..... in. to..... ft., Diameter..... in. to..... ft.

Casing height above land surface .12..... in., Weight 36.95..... lbs./ft., Wall thickness or gauge No. .219.....

TYPE OF SCREEN OR PERFORATION MATERIAL:  
 Steel  Stainless Steel  PVC  Other (Specify) .....  
 Brass  Galvanized Steel  None used (open hole)

SCREEN OR PERFORATION OPENINGS ARE:  
 Continuous slot  Mill slot  Gauze wrapped  Torch cut  Drilled holes  None (open hole)  
 Louvered shutter  Key punched  Wire wrapped  Saw cut  Other (specify) .....

SCREEN-PERFORATED INTERVALS: From 254..... ft. to 296..... ft., From..... ft. to..... ft.  
 From..... ft. to..... ft., From..... ft. to..... ft.

GRAVEL PACK INTERVALS: From 20..... ft. to 316..... ft., From..... ft. to..... ft.  
 From..... ft. to..... ft., From..... ft. to..... ft.

**6 GROUT MATERIAL:**  Neat cement  Cement grout  Bentonite  Other .....

Grout Intervals: From 0..... ft. to 20..... ft., From..... ft. to..... ft., From..... ft. to..... ft.

What is the nearest source of possible contamination:  
 Septic tank  Lateral lines  Pit privy  Livestock pens  Insecticide storage  Other (specify below)  
 Sewer lines  Cesspool  Sewage lagoon  Fuel storage  Abandoned water well  
 Watertight sewer lines  Seepage pit  Feedyard  Fertilizer storage  Oil well/gas well .....

Direction from well .148W & 143N..... Distance from well.....

FROM	TO	LITHOLOGIC LOG	FROM	TO	LITHO. LOG (cont.) or PLUGGING INTERVALS
0	2	TOP SOIL	176	221	SAND FINE TO MED W/ BWN ROCK, CLY LE
2	10	BROWN SAND CLAY	221	230	BRWN SANDY CLAY W/ SAND STRIPS
10	29	BROWN SANDY CLAY W/ FAN LIME RK	230	244	SAND FINE TO MED W / BRWN & TAN ROC
29	57	SAND FINE TO MD COURSE SM GRAV	244	254	SAND FINE TO MED W/ BRWN&TAN RK CLA
57	96	SAND FINE TO MED CRSE, CEMENT	254	280	SAND FINE TO MED/B&T RK CLAY LEDGE
96	110	BROWN SANDY CLAY	280	296	SAND FINE TO MED SM GRAVEL / B&W RK
110	139	SAND TIES TO MUD W/ FEW CLY STRG	296	300	YELLOW SANDSTONE
139	160	BROWN SANDY CLAYW/ SM SD STRIPS	300	310	SHALE
160	170	SAND FINE TO MEDIUM			
170	176	BROWN SANDY CLAY			

**7 CONTRACTOR'S OR LANDOWNER'S CERTIFICATION:** This water well was  constructed,  reconstructed, or  plugged under my jurisdiction and was completed on (mo/day/year) 6:25:11..... and this record is true to the best of my knowledge and belief. Kansas Water Well Contractor's License No. 145..... This Water Well Record was completed on (mo/day/year) 9:9:11..... under the business name of HYDRO RESOURCES..... by (signature) Bruce J. Reichmuth

**INSTRUCTIONS:** Use typewriter or ball point pen. PLEASE PRESS FIRMLY and PRINT clearly. Please fill in blanks and check the correct answers. Send three copies (white, blue, pink) to Kansas Department of Health and Environment, Bureau of Water, Geology Section, 1000 SW Jackson St., Suite 420, Topeka, Kansas 66612-1367. Telephone 785-296-5522. Send one copy to WATER WELL OWNER and retain one for your records. Include fee of \$5.00 for each constructed well. Visit us at <http://www.kdheks.gov/waterwell/index.html>.