

USE TYPEWRITER OR BALL POINT PEN-PRESS FIRMLY, PRINT CLEARLY.

T R EW sec 1/4 1/4 1/4 No.

WATER WELL RECORD
KSA 82a-1201-1215


Kansas State Dept. Of Health
(Water Well Contractors)
Forbes-Bldg. 740
Topeka, Kansas 66620

ACA

| | | | | | | |
|---------------------|------------------------|--|----------|----------------------------|--------------------------|---------------------------|
| 1 Location of well: | County Keany | Township name NE-SW$\frac{1}{4}$ ME$\frac{1}{4}$ | Fraction | Section number 7 | Town number 23 | Range number 36 |
|---------------------|------------------------|--|----------|----------------------------|--------------------------|---------------------------|

Distance and direction from nearest town or city:
3mi west, 8 $\frac{1}{2}$ north 3/4 east of Lakin
Street address of well location if in city:

3 Owner of well:
Address: **Tom Wright
Lakin, Ks. 67860**

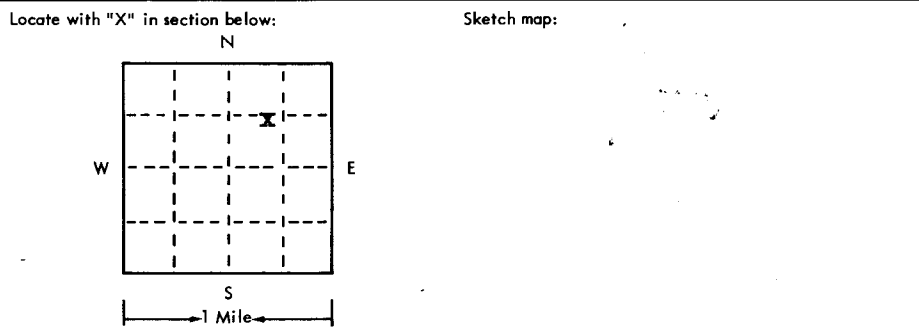

| 2 | Type and color of material | From | To |
|---|--|------|-----|
| | Clay, fine sand | 0 | 20 |
| | Clay | 20 | 40 |
| | Sand | 40 | 60 |
| | Sandy clay, clay | 60 | 100 |
| | Sand ### gravel with clay streaks | 100 | 165 |
| | Soapstone, shale | 165 | 170 |
| | BROCK 165' | | |
| | To be disinfected and completed by Pump Installer | | |

16 Remarks: elevation

Topography:
 Hill
 Slope **Good Drainage**
 Upland
 Valley

4 Well depth: **170** ft. Date of completion **7-15-75**
Well diameter **7 3/4**.

5 Cable tool Rotary Driven Dug
 Hollow rod Jetted Bored Reverse rotary

6 Use: Domestic Public supply Industry
 Irrigation Air conditioning Commercial
 Test well **Pasture**

7 Casing: Material **Plastic** Height: above/below
Threaded Cemented surface **12** in.
Diam. **5"** Weight **320** lbs./ft.
0 in. to **170** ft. depth Drive shoe? Yes No
0 in. to **0** ft. depth

8 Screen:
Manufacturer **Jess & Howell-?**
Type **Plastic** Dia. **5"**
Slot/gauze **1/16** Length **1 $\frac{1}{2}$**
Set between **140** ft. and **150** ft. **1/2**
Fittings: **1/8x5/8**
Gravel pack Yes No Size range of material **1/8x5/8**

9 Static water level:
110 ft. below land surface Date **7-15-75**

10 Pumping level below land surfaces:
0 ft. after **0** hrs. pumping **0** g.p.m.
0 ft. after **0** hrs. pumping **0** g.p.m.
Estimated maximum yield **20** g.p.m.

11 Water sample submitted:
 Yes No Date **7-15-75**

12 Well head completion:
 Pitless adapter Inches above grade

13 Well grouted? Yes No
 Neat cement Bentonite **Clay**
Depth: From **0** ft. to **10** ft.

14 Nearest source of possible contamination: **NA**
ft. _____ Direction _____ Type _____
Well disinfected upon completion? Yes No

15 Pump: Not installed
Manufacturer's name _____
Model number _____ HP _____ Volts _____
Length of drop pipe _____ ft. capacity _____ g.p.m.
Type:
 Submersible Turbine
 Jet Reciprocating
 Centrifugal Other

17 Water well contractor's certification:
This well was drilled under my jurisdiction and this report is true to the best of my knowledge and belief.

High Plains Drilling & Supply, Inc 136
Business name License No. _____
Address **402 N 3rd Garden City, Ks.**
Signed **Bladen & Husband** Date **7-29-75**
Bladen & Husband
Bladen & Husband