

WATER WELL RECORD

Form WWC-5


Division of Water Resources App. No.

1 LOCATION OF WATER WELL: County: Kearny	Fraction ¼ NW ¼ SW ¼ SE ¼	Section Number 2	Township No. T 23 S	Range Number R 36 <input type="checkbox"/> E <input checked="" type="checkbox"/> W
--	------------------------------	---------------------	------------------------	---

Street/Rural Address of Well Location; if unknown, distance & direction from nearest town or intersection: If at owner's address, check here .
HWY 25 & RD. 240, 1 1/2 Miles East 1,200' North

Global Positioning System (GPS) information:
 Latitude: (in decimal degrees)
 Longitude: (in decimal degrees)
 Elevation:
 Datum: WGS 84, NAD 83, NAD 27
 Collection Method:
 GPS unit (Make/Model:)
 Digital Map/Photo, Topographic Map, Land Survey
 Est. Accuracy: <3 m, 3-5 m, 5-15 m, >15 m

2 WATER WELL OWNER: Bill Simshauser
 RR#, Street Address, Box #: 1697 Rd. 240
 City, State, ZIP Code : Lakin, KS 67860

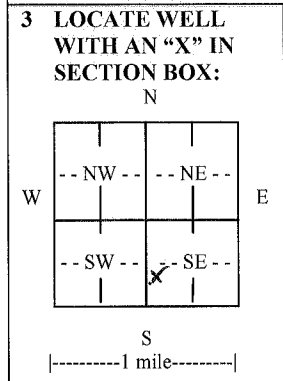

4 DEPTH OF COMPLETED WELL 180 ft.
 Depth(s) Groundwater Encountered (1)..... ft. (2)..... ft. (3)..... ft.
 WELL'S STATIC WATER LEVEL 132ft. below land surface measured on mo/day/yr.....
 Pump test data: Well water was 135ft. after 3 hours pumping 35 gpm
 EST. YIELD 50gpm. Well water wasft. after hours pumping gpm
 Bore Hole Diameter 10in. to 180ft., andin. toft.
 WELL WATER TO BE USED AS: Public water supply Geothermal Injection well
 Domestic Feedlot Oil field water supply Dewatering Other (Specify below)
 Irrigation Industrial Domestic-lawn & garden Monitoring well Live Stock Water
 Was a chemical/bacteriological sample submitted to Department? Yes No
 If yes, mo/day/yr sample was submitted.....
 Water well disinfected? Yes No

5 TYPE OF CASING USED: Steel PVC Other
 CASING JOINTS: Glued Clamped Welded Threaded
 Casing diameter 5 in. to 180 ft., Diameter in. to ft., Diameter in. to ft.
 Casing height above land surface 18 in., Weight 200 lbs./ft., Wall thickness or gauge No. SDR21
 TYPE OF SCREEN OR PERFORATION MATERIAL:
 Steel Stainless Steel PVC Other (Specify)
 Brass Galvanized Steel None used (open hole)
 SCREEN OR PERFORATION OPENINGS ARE:
 Continuous slot Mill slot Gauze wrapped Torch cut Drilled holes None (open hole)
 Louvered shutter Key punched Wire wrapped Saw cut Other (specify)
 SCREEN-PERFORATED INTERVALS: From 140 ft. to 180 ft., From ft. to ft.
 From ft. to ft., From ft. to ft.
 GRAVEL PACK INTERVALS: From 25 ft. to 180 ft., From ft. to ft.
 From ft. to ft., From ft. to ft.

6 GROUT MATERIAL: Neat cement Cement grout Bentonite Other
 Grout Intervals: From 0 ft. to 25 ft., From ft. to ft., From ft. to ft.
 What is the nearest source of possible contamination:
 Septic tank Lateral lines Pit privy Livestock pens Insecticide storage Other (specify below)
 Sewer lines Cesspool Sewage lagoon Fuel storage Abandoned water well
 Watertight sewer lines Seepage pit Feedyard Fertilizer storage Oil well/gas well
 Direction from well South East Distance from well 1/4 Mile

FROM	TO	LITHOLOGIC LOG	FROM	TO	LITHO. LOG (cont.) or PLUGGING INTERVALS
0	2	Top Soil	122	140	Brown Caly, Few Medium Sand Streaks
2	34	Brown Clay, Medium Sand Mix	140	155	Medium to Coarse Sand, Small Gravel
34	41	Medium Sand			White Broken Rock (Loose, Clean)
41	55	Medium Sand, Brown Clay Streaks	155	159	Brown Clay
55	81	Brown Caly, Medium Sand Streaks Cem	159	173	Medium to Coarse Sand, Small Gravel
81	85	Medium Sand			White Broken Rock (Loose, Clean)
85	97	Cemented Sand, Few Medium Sand Str.	173	178	Brown Caly, Few Small Medium Sand
97	105	Gypsum, Brown Clay			Streaks.White Broken Rock
105	122	Medium to Coarse Sand, Small Gravel	178	180	Brown Clay
		White Broken Rock (Loose, Clean)			

7 CONTRACTOR'S OR LANDOWNER'S CERTIFICATION: This water well was constructed, reconstructed, or plugged under my jurisdiction and was completed on (mo/day/year) 11-25-13 and this record is true to the best of my knowledge and belief.
 Kansas Water Well Contractor's License No. 532 This Water Well Record was completed on (mo/day/year) 11-27-13
 under the business name of Midwest Well & Pump Inc. by (signature)

INSTRUCTIONS: Use typewriter or ball point pen. PLEASE PRESS FIRMLY and PRINT clearly. Please fill in blanks and check the correct answers. Send three copies (white, blue, pink) to Kansas Department of Health and Environment, Bureau of Water, Geology Section, 1000 SW Jackson St., Suite 420, Topeka, Kansas 66612-1367. Telephone 785-296-5522. Send one copy to WATER WELL OWNER and retain one for your records. Include fee of \$5.00 for each constructed well. Visit us at <http://www.kdheks.gov/waterwell/index.html>.