

**WATER WELL PLUGGING RECORD Form WWC-5P**

KSA 82a-1212

ID NO.

No ID. #


<b>1 LOCATION OF WATER WELL:</b> County: <u>Kearny</u> Fraction <u>NE</u> <input type="checkbox"/> NE <input type="checkbox"/> ¼ NE <input type="checkbox"/> ¼ NW <input type="checkbox"/> ¼ <input type="checkbox"/> W	Section Number <u>30</u>	Township Number T <u>23</u> S	Range Number <u>36</u> <input type="checkbox"/> E <input checked="" type="checkbox"/> W
--	-----------------------------	----------------------------------	--

Street/Rural Address of Well Location; if unknown, distance & direction from nearest town or intersection: If at owner's address, check here  From Lakin ks, 6 mi. N then 2.53 mi. w then 172 ft. south

**Global Positioning Systems (GPS) information:**  
Latitude: 38.031080 (in decimal degrees)  
Longitude: -101.314158 (in decimal degrees)  
Elevation: 3244  
Horizontal Datum:  WGS84,  NAD83,  NAD27  
Collection Method:

**2 WATER WELL OWNER:** Graham Farms Inc.  
RR#, St. Address, Box #: 2150 Rd. 220  
City, State ZIP Code: Deerfield Ks. 67838

GPS unit (Make/Model: Google earth)  
 Digital Map/Photo,  Topographic Map,  Land Survey  
Est. Accuracy:  < 3 m,  3-5 m,  5-15 m,  > 15 m

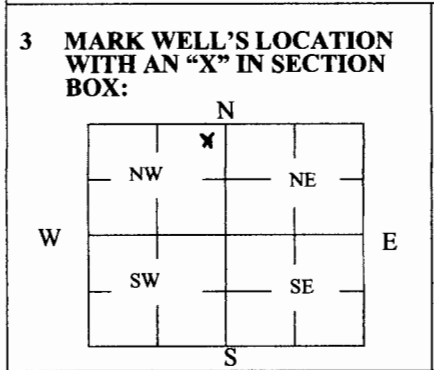

**4 DEPTH OF WELL** 315 ft.  
WELL'S STATIC WATER LEVEL 249 ft.  
WELL WAS USED AS:  
 Domestic  Public Water Supply  Dewatering  
 Irrigation  Oil Field Water Supply  Monitoring  
 Feedlot  Domestic (Lawn & Garden)  Injection Well  
 Industrial  Air Conditioning  Other Never used  
Was a chemical/bacteriological sample submitted to Department? Yes  No

**5 TYPE OF BLANK CASING USED:**  
 Steel  RMP (SR)  Wrought  Fiberglass  Other (Specify below)  
 PVC  ABS  Asbestos-Cement  Concrete Tile PVC .410 wall thickness  
Blank casing diameter 8 in. Was casing pulled? Yes  No  If yes, how much 7  
Casing height above or below land surface 24 in.

**6 GROUT PLUG MATERIAL:**  Neat cement  Cement grout  Bentonite  Other \_\_\_\_\_  
Grout Plug Intervals: From 8 ft. to 4 ft., From \_\_\_\_\_ ft. to \_\_\_\_\_ ft., From \_\_\_\_\_ ft. to \_\_\_\_\_ ft.  
What is the nearest source of possible contamination:  
 Septic tank  Seepage pit  Fuel storage  Other (specify below)  
 Sewer lines  Pit privy  Fertilizer storage salt water storage gas/oil  
 Watertight sewer lines  Sewage lagoon  Insecticide storage  
 Lateral lines  Feedyard  Abandoned water well Direction from well? ne  
 Cess pool  Livestock pens  Oil well/Gas well How many feet? 2800

FROM	TO	PLUGGING MATERIALS	FROM	TO	PLUGGING MATERIALS
315	240	gravel			
240	8	clay-silt			
8	5	Bentonite			
5	4	Bentonite extended cap			
4	0	clay silt			

**7 CONTRACTOR'S OR LANDOWNER'S CERTIFICATION:** This water well was plugged under my jurisdiction and was completed on (mo/day/year) 06/06/2017 and this record is true to the best of my knowledge and belief. Kansas Water Well Contractor's License No. 970-907. This Water Well Record was completed on (mo/day/year) 06/06/2017 under the business name of Larry Graham by (signature) [Signature]

Send one white copy to Kansas Department of Health & Environment, Geology Section, 1000 SW Jackson Street, Ste. 420, Topeka, KS 66612-1367. Send one copy to WATER WELL OWNER and retain one for your records.  
Visit us at <http://www.kdheks.gov/waterwell/index.html> Telephone 785-296-5524.