

WATER WELL PLUGGING RECORD Form WWC-5P

KSA 82a-1212


ID NO.

No ID. #

1 LOCATION OF WATER WELL: County: <u>Kearny</u> Fraction <u>SW 1/4 NW 1/4 NW 1/4</u> Section Number <u>30</u> Township Number <u>T 23 S</u> Range Number <u>36</u> <input type="checkbox"/> E <input checked="" type="checkbox"/> W

Street/Rural Address of Well Location; if unknown, distance & direction from nearest town or intersection: If at owner's address, check here <input type="checkbox"/> From <u>Lakin ks, 6 mi. N then 3 mi. w then .25 south</u>	Global Positioning Systems (GPS) information: Latitude: <u>38.028135</u> (in decimal degrees) Longitude: <u>-101.321988</u> (in decimal degrees) Elevation: <u>3153</u> Horizontal Datum: <input checked="" type="checkbox"/> WGS84, <input type="checkbox"/> NAD83, <input type="checkbox"/> NAD27 Collection Method:
---	--

2 WATER WELL OWNER: <u>Graham Farms Inc.</u> RR#, St. Address, Box #: <u>2150 Rd. 220</u> City, State ZIP Code: <u>Deerfield Ks. 67838</u>	<input checked="" type="checkbox"/> GPS unit (Make/Model: <u>Google earth</u>) <input checked="" type="checkbox"/> Digital Map/Photo, <input type="checkbox"/> Topographic Map, <input type="checkbox"/> Land Survey Est. Accuracy: <input type="checkbox"/> < 3 m, <input checked="" type="checkbox"/> 3-5 m, <input type="checkbox"/> 5-15 m, <input type="checkbox"/> > 15 m
---	--

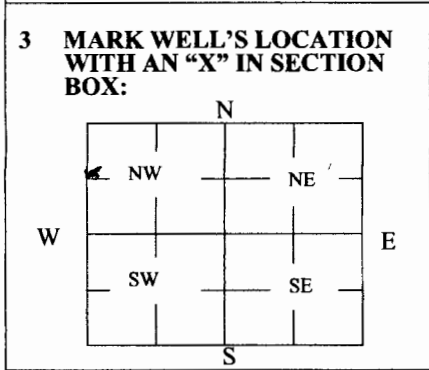

4 DEPTH OF WELL 300 ft.
WELL'S STATIC WATER LEVEL 240 ft.
WELL WAS USED AS:
 Domestic Public Water Supply Dewatering
 Irrigation Oil Field Water Supply Monitoring
 Feedlot Domestic (Lawn & Garden) Injection Well
 Industrial Air Conditioning Other Never used
 Was a chemical/bacteriological sample submitted to Department? Yes No

5 TYPE OF BLANK CASING USED:
 Steel RMP (SR) Wrought Fiberglass Other (Specify below)
 PVC ABS Asbestos-Cement Concrete Tile PVC .410 wall thickness
 Blank casing diameter 8 in. Was casing pulled? Yes No If yes, how much 6
 Casing height above or below land surface 24 in.

6 GROUT PLUG MATERIAL: Neat cement Cement grout Bentonite Other _____
 Grout Plug Intervals: From 8 ft. to 4 ft., From _____ ft. to _____ ft., From _____ ft. to _____ ft.
 What is the nearest source of possible contamination:
 Septic tank Seepage pit Fuel storage Other (specify below) salt water storage gas/oil
 Sewer lines Pit privy Fertilizer storage
 Watertight sewer lines Sewage lagoon Insecticide storage
 Lateral lines Feedyard Abandoned water well Direction from well? ne
 Cess pool Livestock pens Oil well/Gas well How many feet? 2800

FROM	TO	PLUGGING MATERIALS	FROM	TO	PLUGGING MATERIALS
300	235	gravel			
235	7	clay-silt			
7	4	Bentonite			
4	3	Bentonite extended cap			
3	0	clay silt			

7 CONTRACTOR'S OR LANDOWNER'S CERTIFICATION: This water well was plugged under my jurisdiction and was completed on (mo/day/year) 06/05/2017 and this record is true to the best of my knowledge and belief. Kansas Water Well Contractor's License No. 970 907. This Water Well Record was completed on (mo/day/year) 06/06/2017 under the business name of Larry Graham by (signature) [Signature]

Send one white copy to Kansas Department of Health & Environment, Geology Section, 1000 SW Jackson Street, Ste. 420, Topeka, KS 66612-1367. Send one copy to WATER WELL OWNER and retain one for your records.
 Visit us at <http://www.kdheks.gov/waterwell/index.html> Telephone 785-296-5524.