


1 LOCATION OF WATER WELL: Fraction SE 1/4 SE 1/4 SE 1/4 Section Number 4 Township Number T 23 S Range Number R 37 E/W
 County: KEARNY

Distance and direction from nearest town or city street address of well if located within city?

6 mi. west, 9 mi. north of Lakin, Kansas

2 WATER WELL OWNER: Teresa Modie Trust POWER OF ATTORNEY: Donald E. Summers
 RR#, St. Address, Box #: Box 201 Route 1, Box 24A Board of Agriculture, Division of Water Resources
 City, State, ZIP Code: Lakin, Kansas 67860 Lakin, Kansas 67860 Application Number:

3 LOCATE WELL'S LOCATION WITH AN "X" IN SECTION BOX:

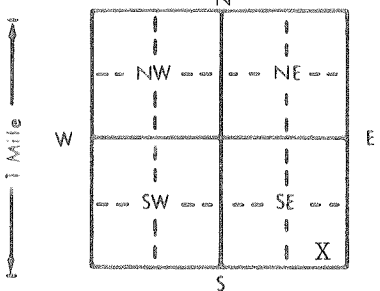

4 DEPTH OF COMPLETED WELL: 219 ft. ELEVATION: NA

Depth(s) Groundwater Encountered 1. NA ft. 2. NA ft. 3. NA ft.

WELL'S STATIC WATER LEVEL: 207 ft. below land surface measured on mo/day/yr Nov. 5, 1992

Pump test data: Well water was NA ft. after NA hours pumping NA gpm

Est. Yield NA gpm: Well water was NA ft. after NA hours pumping NA gpm

Bore Hole Diameter: 6 in. to NA ft., and NA in. to NA ft.

WELL WATER TO BE USED AS: 5 Public water supply 8 Air conditioning 11 Injection well

XX Domestic 3 Feedlot 6 Oil field water supply 9 Dewatering 12 Other (Specify below)

2 Irrigation 4 Industrial 7 Lawn and garden only 10 Monitoring well NA

Was a chemical/bacteriological sample submitted to Department? Yes No X; If yes, mo/day/yr sample was submitted NA

Water Well Disinfected? Yes X No

5 TYPE OF BLANK CASING USED: 5 Wrought iron 8 Concrete tile CASING JOINTS: Glued XXX Clamped
 XX Steel 3 RMP (SR) 6 Asbestos-Cement 9 Other (specify below) Welded
 2 PVC 4 ABS 7 Fiberglass NA Threaded

Blank casing diameter: 6 in. to NA ft., Dia NA in. to NA ft., Dia NA in. to NA ft.

Casing height above land surface: 5 feet in., weight NA lbs./ft. Wall thickness or gauge No. NA

TYPE OF SCREEN OR PERFORATION MATERIAL: 7 PVC 10 Asbestos-cement

1 Steel 3 Stainless steel 5 Fiberglass 8 RMP (SR) 11 Other (specify) NA

2 Brass 4 Galvanized steel 6 Concrete tile 9 ABS 12 None used (open hole)

SCREEN OR PERFORATION OPENINGS ARE: 5 Gauzed wrapped 8 Saw cut 11 None (open hole)

1 Continuous slot 3 Mill slot 6 Wire wrapped 9 Drilled holes

2 Louvered shutter 4 Key punched 7 Torch cut 10 Other (specify) NA

SCREEN-PERFORATED INTERVALS: From NA ft. to NA ft., From NA ft. to NA ft.

From NA ft. to NA ft., From NA ft. to NA ft.

GRAVEL PACK INTERVALS: From NA ft. to NA ft., From NA ft. to NA ft.

From NA ft. to NA ft., From NA ft. to NA ft.

6 GROUT MATERIAL: 1 Neat cement XX 2 Cement grout 3 Bentonite 4 Other

Grout Intervals: From 8 ft. to 5 ft., From NA ft. to NA ft., From NA ft. to NA ft.

What is the nearest source of possible contamination: 10 Livestock pens 14 Abandoned water well

1 Septic tank 4 Lateral lines 7 Pit privy 11 Fuel storage 15 Oil well/Gas well

2 Sewer lines 5 Cess pool 8 Sewage lagoon 12 Fertilizer storage 16 Other (specify below)

3 Watertight sewer lines 6 Seepage pit 9 Feedyard 13 Insecticide storage Livestock corral and pesticide runoff

Direction from well? Corral: 50 feet north; Pesticide: To S. & W., 1 mi. How many feet? pesticide runoff

FROM	TO	LITHOLOGIC LOG	FROM	TO	PLUGGING INTERVALS
219'	207'	Sand			
207'	8'	Dirt/Clay			
8'	5'	Concrete (Plug)			
5'	0'	XXXXXXXX Closed pit			
<p>This abandoned well is in a pit. This pit is being used, to enclose an active pressure tank. Therefore, the well was filled and plugged to the level of the pit floor. The casing was cut off flush with the floor, and the concrete plug thoroughly seals the casing by surrounding it along the sides and top, forming a mushroom-like shape.</p>					

7 CONTRACTOR'S OR LANDOWNER'S CERTIFICATION: This water well was (1) constructed, (2) reconstructed, or (3) plugged under my jurisdiction and was completed on (mo/day/year) 2/7/93 and this record is true to the best of my knowledge and belief. Kansas Water Well Contractor's License No. NA This Water Well Record was completed on (mo/day/yr) 2/10/93 under the business name of Donald E. Summers, P.O.A. by (signature) Donald E. Summers P.O.A.