


1 LOCATION OF WATER WELL: County: KEARNY Fraction SE 1/4 SE 1/4 NE 1/4 Section Number 9 Township Number T 23 S Range Number R 37 EW

Distance and direction from nearest town or city street address of well if located within city?

6 mi. west, 8 1/2 mi. north of Lakin, Kansas.

2 WATER WELL OWNER: Ethel M. Martin RR#, St. Address, Box #: Box 669 City, State, ZIP Code: Syracuse, Kansas 67878 Board of Agriculture, Division of Water Resource Application Number: NA

3 LOCATE WELL'S LOCATION WITH AN "X" IN SECTION BOX:

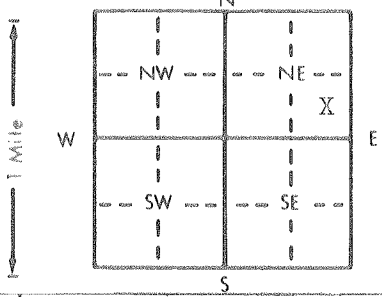

4 DEPTH OF COMPLETED WELL: 198 ft. ELEVATION: NA ft. Depth(s) Groundwater Encountered: 1. NA ft. 2. NA ft. 3. NA ft. WELL'S STATIC WATER LEVEL: DRY ft. below land surface measured on mo/day/yr Nov. 5, 1992 Pump test data: Well water was NA ft. after NA hours pumping NA gpm Est. Yield NA gpm: Well water was NA ft. after NA hours pumping NA gpm Bore Hole Diameter: NA in. to NA ft., and NA in. to NA ft. WELL WATER TO BE USED AS: 1 Domestic 3 Feedlot 5 Public water supply 8 Air conditioning 11 Injection well 2 Irrigation 4 Industrial 6 Oil field water supply 9 Dewatering 12 Other (Specify below) 7 Lawn and garden only 10 Monitoring well Was a chemical/bacteriological sample submitted to Department? Yes No X; If yes, mo/day/yr sample was submitted Water Well Disinfected? Yes YES No X

5 TYPE OF BLANK CASING USED: 1 Steel 3 RMP (SR) 5 Wrought iron 8 Concrete tile CASING JOINTS: Glued Clamped X Welded Threaded 2 PVC 4 ABS 7 Fiberglass Galvanized tin

Blank casing diameter: 5 in. to NA ft., Dia NA in. to NA ft., Dia NA in. to NA ft. Casing height above land surface: flush w/surface weight NA lbs./ft. Wall thickness or gauge No. NA

TYPE OF SCREEN OR PERFORATION MATERIAL: 1 Steel 3 Stainless steel 5 Fiberglass 8 RMP (SR) 10 Asbestos-cement 11 Other (specify) NA 2 Brass 4 Galvanized steel 6 Concrete tile 9 ABS 12 None used (open hole)

SCREEN OR PERFORATION OPENINGS ARE: 1 Continuous slot 3 Mill slot 5 Gauzed wrapped 8 Saw cut 11 None (open hole) 2 Louvered shutter 4 Key punched 6 Wire wrapped 9 Drilled holes 10 Other (specify) NA 7 Torch cut

SCREEN-PERFORATED INTERVALS: From NA ft. to NA ft., From NA ft. to NA ft., From NA ft. to NA ft. GRAVEL PACK INTERVALS: From NA ft. to NA ft., From NA ft. to NA ft., From NA ft. to NA ft.

6 GROUT MATERIAL: 1 Neat cement 2 Cement grout X 3 Bentonite 4 Other For plug Grout Intervals: From 6 ft. to 3 ft., From ft. to ft., From ft. to ft.

What is the nearest source of possible contamination: 1 Septic tank 4 Lateral lines 7 Pit privy 10 Livestock pens 14 Abandoned water well 2 Sewer lines 5 Cess pool 8 Sewage lagoon 11 Fuel storage 15 Oil well/Gas well 3 Watertight sewer lines 6 Seepage pit 9 Feedyard 12 Fertilizer storage 16 Other (specify below) 13 Insecticide storage X Crop insecticides and herbicides sprayed

Direction from well? All around How many feet?

FROM	TO	LITHOLOGIC LOG	FROM	TO	PLUGGING INTERVALS
198	193	Sand and Gravel (buffer against water/moisture)			
193	6	Clay/dirt			
6	3	Cement			
3	0	Fill Dirt			

7 CONTRACTOR'S OR LANDOWNER'S CERTIFICATION: This water well was (1) constructed, (2) reconstructed, or X plugged under my jurisdiction and was completed on (mo/day/year) 11/15/92 and this record is true to the best of my knowledge and belief. Kansas Water Well Contractor's License No. This Water Well Record was completed on (mo/day/yr) 12/28/92 1/4/93 under the business name of Ethel M. Martin by (signature) Ethel M. Martin P.O.A.