


WATER WELL RECORD Form WWC-5 KSA 82a-1212

1 LOCATION OF WATER WELL: Fraction Section Number Township Number Range Number  
 COUNTY: KEARNEY NE 1/4 NE 1/4 NE 1/4 6 T 23 S R 37 W

Distance and direction from nearest town or city street address of well if located within city?  
 FROM LAKIN - W 50<sup>th</sup> HIGHWAY 6M TO K RD. NTO 250RD W 2 MILES

2 WATER WELL OWNER: BEREXCO (Patterson Control Tank Battlery)  
 RR#, St. Address, Box #: PO BOX 20380 Board of Agriculture, Division of Water Resources  
 City, State, ZIP code: WICHITA, KS 67208- Application Number:

3 LOCATE WELL'S LOCATION WITH AN "X" IN SECTION BOX:

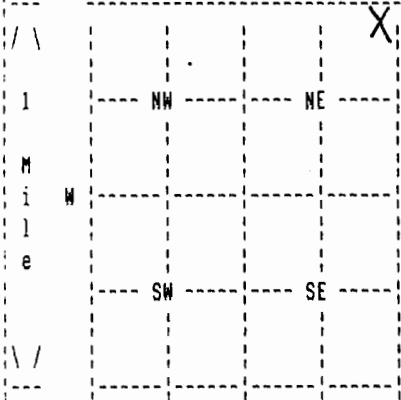

4 DEPTH OF COMPLETED WELL 256 ELEVATION: 0  
 Depth(s) Groundwater Encountered 1. 0 ft. 2. 0 ft. 3. 0 ft.

WELL'S STATIC WATER LEVEL 192 ft. below land surface measured on mo/day/yr 06/08/10  
 Pump testdata: Well water was 0 ft. after 0 hours pumping 0 gpm

Estimated Yield 10 gpm: Well water was 0 ft. after 0 hours pumping 0 gpm

Bore Hole Diameter 10 in. to 256 ft., and in. to 0 ft.

WELL WATER TO BE USED AS: DOMESTIC

Was a chemical/bacteriological sample submitted to department? No ;  
 If yes, mo/day/yr sample was submitted Water well disinfected? Yes

5 TYPE OF BLANK CASING USED: CERTA LOC CASIN CASING JOINTS: CERTA-LOC  
 Blank casing diameter 5 in. to 256 ft., Dia in. to 0 ft., Dia in. to 0 ft.  
 Casing height above land surface 12 in., weight 200 lbs/ft. Wall thickness or gauge No. 21  
 TYPE OF SCREEN OR PERFORATION MATERIAL: PVC  
 SCREEN OR PERFORATION OPENINGS ARE: SAW CUT

SCREEN PERFORATED INTERVALS: From 190 ft. to 256 ft., From 0 ft. to 0 ft.  
 From 0 ft. to 0 ft., From 0 ft. to 0 ft.  
 GRAVEL PACK INTERVALS: From 25 ft. to 256 ft., From 0 ft. to 0 ft.  
 From 0 ft. to 0 ft., From 0 ft. to 0 ft.

6 GROUT MATERIAL BENTONITE  
 Grout Intervals: From 5 ft. to 25 ft., From 0 ft. to 0 ft., From 0 ft. to 0 ft.  
 What is the nearest source of possible contamination: NONE  
 Direction from well? How many feet? 0

FROM	TO	LITHOLOGIC LOG	FROM	TO	PLUGGING INTERVALS
0	20	01 TOPSOIL 05 CLAY 02 FINE SAND			
20	60	37 FIN-COAR SAN			
60	80	37 FIN-COAR SAN 06 SMALL GRAVEL			
80	100	10 FINE-MEDSAND 14 WHITE CLAY			
100	160	02 FINE SAND 17 CLAY LAYERS			
160	200	37 FIN-COAR SAN 06 SMALL GRAVEL			
200	230	37 FIN-COAR SAN 17 CLAY LAYERS			
230	240	08 ROCK LAYERS 07 BLUE SHALE			
240	260	08 ROCK LAYERS 07 BLUE SHALE			

7 CONTRACTOR'S OR LANDOWNER'S CERTIFICATION: This water well was Constructed under my jurisdiction and was completed on (mo/day/year) 06/23/10 and this record is true to the best of my knowledge and belief. Kansas Water Well Contractor's License No. 179 This Water Well Record was completed on (mo/day/yr) 07/22/10 under the business name of JOE'S WELL SERVICE, INC. by (signature) *Judith Crick*