

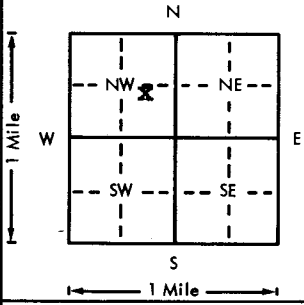
LEOTI 3 SW

BDB

USE TYPEWRITER OR BALL POINT PEN-PRESS FIRMLY, PRINT CLEARLY.

WATER WELL RECORD
KSA 82a-1201-1215

Kansas Department of Health and Environment-Division of Environment
(Water well Contractors)
Topeka, Kansas 66620

1. Location of well:		County Kearny	Fraction NW 1/4 SE 1/4 NW 1/4	Section number 33	Township number T 23 S R 37 NW	Range number
2. Distance and direction from nearest town or city: 7 west, 4 3/4 north, 1/4 southeast of Lakin. Street address of well location if in city:			3. Owner of well: Brad Tate R.R. or street: Lakin, Ks. 67860 City, state, zip code:			
4. Locate with "X" in section below: 			Sketch map:		6. Bore hole dia. 26 in. Completion date 10-13-76 Well depth 310 ft.	
5. Type and color of material			From	To	7. <input type="checkbox"/> Cable tool <input type="checkbox"/> Rotary <input type="checkbox"/> Driven <input type="checkbox"/> Dug <input type="checkbox"/> Hollow rod <input type="checkbox"/> Jetted <input type="checkbox"/> Bored <input checked="" type="checkbox"/> Reverse rotary	
BRUCK 302'					8. Use: <input type="checkbox"/> Domestic <input type="checkbox"/> Public supply <input type="checkbox"/> Industry <input checked="" type="checkbox"/> Irrigation <input type="checkbox"/> Air conditioning <input type="checkbox"/> Stock <input type="checkbox"/> Lawn <input type="checkbox"/> Oil field water <input type="checkbox"/> Other	
					9. Casing: Material steel Height: Above or below Threaded <input type="checkbox"/> Welded <input checked="" type="checkbox"/> Surface 12 in. RMP <input type="checkbox"/> PVC <input type="checkbox"/> Weight 36.87 lbs./ft. Dia. 16 in. to 311 ft. depth Wall Thickness: inches or Dia. <input type="checkbox"/> in. to <input type="checkbox"/> ft. depth gage No. 250	
					10. Screen: Manufacturer's name Johnson Type Galv. Dia. 16" Slot/gauge <input type="checkbox"/> Length 20 ft. Set between 282 ft. and 302 ft. Perf: 250-282 ft. and 302-310 ft. Gravel pack? <input checked="" type="checkbox"/> yes Size range of material 1/2" down	
					11. Static water level: <input type="checkbox"/> mo./day/yr. 255 ft. below land surface Date 8-12-76	
					12. Pumping level below land surfaces: 273 ft. after 2 hrs. pumping 450 g.p.m. 287 ft. after 4 hrs. pumping 575 g.p.m. Estimated maximum yield 575 g.p.m.	
					13. Water sample submitted: <input type="checkbox"/> mo./day/yr. <input type="checkbox"/> Yes <input checked="" type="checkbox"/> No Date	
					14. Well head completion: <input type="checkbox"/> Pitless adapter 12 Inches above grade	
					15. Well grouted? <input checked="" type="checkbox"/> yes With: <input type="checkbox"/> Neat cement <input type="checkbox"/> Bentonite <input checked="" type="checkbox"/> Concrete Depth: From 0 ft. to 10 ft.	
					16. Nearest source of possible contamination: N/A ft. <input type="checkbox"/> Direction <input type="checkbox"/> Type <input type="checkbox"/> Well disinfected upon completion? <input type="checkbox"/> Yes <input checked="" type="checkbox"/> No	
					17. Pump: <input type="checkbox"/> Not installed Manufacturer's name Goulds-US Pump Model number 10 JHC HP 100 Volts <input type="checkbox"/> Length of drop pipe 300 ft. capacity 500 g.p.m. Type: <input type="checkbox"/> Submersible <input checked="" type="checkbox"/> Turbine <input type="checkbox"/> Jet <input type="checkbox"/> Reciprocating <input type="checkbox"/> Centrifugal <input type="checkbox"/> Other	
(Use a second sheet if needed)						
18. Elevation:	19. Remarks: 3288 (TOPO)		20. Water well contractor's certification: This well was drilled under my jurisdiction and this report is true to the best of my knowledge and belief. Minter-Wilson Drilling Co. 208 Business name License No. Address Box A Garden City, Ks. Signed <i>[Signature]</i> Date 5-13-76 Authorized representative			
Topography: <input type="checkbox"/> Hill <input checked="" type="checkbox"/> Slope <input type="checkbox"/> Upland <input type="checkbox"/> Valley						

76

T 23 S R 37 NW SE NW
1/4 1/4 1/4 1/4

Forward the white, blue and pink copies to the Department of Health and Environment

Form WWC-5

The Professionals

MINTER-WILSON DRILLING CO.

INCORPORATED

Irrigation
and Domestic
Water Systems
Complete Installation
and Repairing

Phone 276-8269 • P.O. Box 493 • GARDEN CITY, KANSAS 67846

BRAD TATE
KEARNY COUNTY
7-23-76

Location: NW $\frac{1}{4}$ 33-23-37 7 miles west $4 \frac{3}{4}$ north $\frac{1}{4}$ east in the
field from Lakin

Static Water Level-240'

Test #1

0	2	Topsoil
2	8	Brown clay
8	31	Brown sandyclay
31	64	Fine to med. sand and gravel
64	78	Brown sandyclay
78	111	Fine to med. sand and gravel
111	142	Brown sandy clay
142	171	Fine to med. sand tight
171	229	Fine to med. sand and gravel
229	246	Fine to sand 40% clay hard pull down
246	253	Fine to med. sand and gravel
253	271	Fine to med. sand and gravel tight
271	290	Fine to med. sand and gravel
290	302	Fine to med. sand and gravel mixed white rock
302	315	Yellow clay hard pull down
315	320	Shale

T.D. 310'
Screen 20