

USE TYPEWRITER OR BALL POINT PEN. PRESS FIRMLY, PRINT CLEARLY.


LEOTI 3SE

CDB

WATER WELL RECORD  
KSA 82a-1201-1215

Kansas Department of Health and Environment-Division of Environment  
(Water well Contractors)  
Topeka, Kansas 66620

1. Location of well:		County <b>Kearny</b>	Fraction <b>NW 1/4 SE 1/4 SW 1/4</b>	Section number <b>34</b>	Township number <b>T 23 S R 37 1/4N</b>	Range number	
2. Distance and direction from nearest town or city: <b>6 west, 4 1/2 north</b> Street address of well location if in city: <b>1/4 east of Lakin</b>			3. Owner of well: <b>Ed Wiatt</b> R.R. or street: <b>Lakin, Ks. 67860</b> City, state, zip code:				
4. Locate with "X" in section below:		Sketch map:			6. Bore hole dia. <u>26</u> in. Completion date <u>2-26-76</u> Well depth <u>287</u> ft.		
					7. <input type="checkbox"/> Cable tool <input type="checkbox"/> Rotary <input type="checkbox"/> Driven <input type="checkbox"/> Dug <input type="checkbox"/> Hollow rod <input type="checkbox"/> Jetted <input type="checkbox"/> Bored <input checked="" type="checkbox"/> Reverse rotary		
					8. Use: <input type="checkbox"/> Domestic <input type="checkbox"/> Public supply <input type="checkbox"/> Industry <input checked="" type="checkbox"/> Irrigation <input type="checkbox"/> Air conditioning <input type="checkbox"/> Stock <input type="checkbox"/> Lawn <input type="checkbox"/> Oil field water <input type="checkbox"/> Other		
					9. Casing: Material <u>Steel</u> Height: Above ground <u>12</u> in. Threaded <input type="checkbox"/> Welded <input checked="" type="checkbox"/> Surface <u>12</u> in. RMP <input type="checkbox"/> PVC <input type="checkbox"/> Weight <u>36.87</u> lbs./ft. Dia. <u>16</u> in. to <u>288</u> ft. depth Wall Thickness: inches or Dia. <u>   </u> in. to <u>   </u> ft. depth gage No. <u>   </u>		
5. Type and color of material		From	To	10. Screen: Manufacturer's name <u>Johnson Division</u> Type <u>Galv.</u> Dia. <u>16"</u> Slot/gage <u>100</u> Length <u>20'</u> Set between <u>260</u> ft. and <u>280</u> ft. Depth: <u>250-260</u> ft. and <u>280-287</u> ft. Gravel pack? <input checked="" type="checkbox"/> Size range of material <u>1/2" down</u>			
<u>BROCK 287'</u>				11. Static water level: <u>238</u> ft. below land surface Date <u>2-26-76</u> mo./day/yr.			
				12. Pumping level below land surfaces: <u>275</u> ft. after <u>3</u> hrs. pumping <u>475</u> g.p.m. <u>   </u> ft. after <u>   </u> hrs. pumping <u>   </u> g.p.m. Estimated maximum yield <u>475</u> g.p.m.			
				13. Water sample submitted: <u>   </u> mo./day/yr. Yes <input type="checkbox"/> No <input checked="" type="checkbox"/> Date <u>   </u>			
				14. Well head completion: <input type="checkbox"/> Pitless adapter <u>12</u> inches above grade			
				15. Well grouted? <u>yes</u> With: <input checked="" type="checkbox"/> Neat cement <input type="checkbox"/> Bentonite <input type="checkbox"/> Concrete Depth: From <u>0</u> ft. to <u>10</u> ft.			
				16. Nearest source of possible contamination: <u>N/A</u> ft. <u>   </u> Direction <u>   </u> Type <u>   </u> Well disinfected upon completion? <input type="checkbox"/> Yes <input checked="" type="checkbox"/> No			
				17. Pump: <u>Not installed</u> Manufacturer's name <u>Gouids - US Pump</u> Model number <u>10JHC</u> HP <u>60</u> Volts <u>   </u> Length of drop pipe <u>230</u> ft. capacity <u>475</u> g.p.m. Type: <input type="checkbox"/> Submersible <input checked="" type="checkbox"/> Turbine <input type="checkbox"/> Jet <input type="checkbox"/> Reciprocating <input type="checkbox"/> Centrifugal <input type="checkbox"/> Other			
18. Elevation:		19. Remarks:				20. Water well contractor's certification: This well was drilled under my jurisdiction and this report is true to the best of my knowledge and belief. <b>MINTER-WILSON DRILLING 208</b> Business name <u>P.O. Box A Garden City, Ks</u> License No. <u>   </u> Address <u>   </u> City <u>   </u> State <u>   </u> Zip <u>   </u> Signed <u>   </u> Date <u>7-16</u> Authorized representative	
Topography: <input type="checkbox"/> Hill <input checked="" type="checkbox"/> Slope <input type="checkbox"/> Upland <input type="checkbox"/> Valley		<u>3293 (TOPO)</u>					

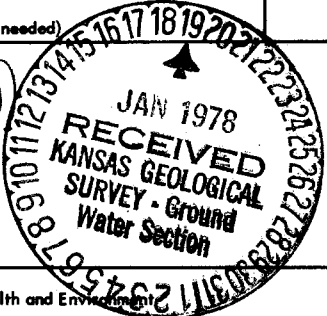

23 37 34 1/4 NW SE SW

The  
Professionals

**MINTER-WILSON DRILLING CO.**  
-INCORPORATED

Irrigation  
and Domestic  
Water Systems  
Complete Installation  
and Repairing

Phone 276-8269 • P.O. Box 493 • GARDEN CITY, KANSAS 67846

**ED WIATT**  
Kearney County  
1-31-76

**Location SW 34-23-37**  
From Test #2 In The Corner, Go  $\frac{1}{2}$  Mile North  
 $\frac{1}{2}$  Mile East, On South Side Of Road

**Static Water Level 240'**

Test #3		
0	2	Top Soil
2	35	Brown Clay, Mixed Brown Rock
35	42	Fine To Med. Sand & Gravel
42	46	Brown Sandy Clay
46	64	Fine To Med. Sand & Gravel <i>Hard</i>
64	86	Brown Sandy Clay
86	93	Fine To Med. Sand & Gravel
93	115	Brown Sandy Clay
115	122	Fine To Med. Sand & Gravel
122	138	Brown Sandy Clay
138	163	Fine To Med. Sand (Tight)
163	179	Brown Sandy Clay
179	191	Med. Sand & Gravel
191	201	Brown Sandy Clay
201	223	Fine To Med. Sand & Gravel
223	243	Brown Sandy Clay
243	262	Med. Sand & Gravel
262	270	Med. Sand & Gravel (Loose)
270	287	Med. Sand & Gravel, Mixed White Rock (Loose)
287	299	Yellow Clay
299	310	Brown Rock (Hard, Hard)
310	315	Shale

TD 287'  
20' Screen