


1 LOCATION OF WATER WELL: Fraction Section Number Township Number Range Number  
 COUNTY: 038 HAMILTON NE 1/4 SW 1/4 SW 1/4 14 T 23 S R 39 W

Distance and direction from nearest town or city street address of well if located within city?  
 APPROX. 1 MILE WEST AND 7.125 MILES NORTH OF KENDALL

2 WATER WELL OWNER: HORTON, HARVEY  
 RR#, St. Address, Box #: NRR BOX 13A Board of Agriculture, Division of Water Resources  
 City, State, ZIP code: KENDALL, KS 67857- Application Number:

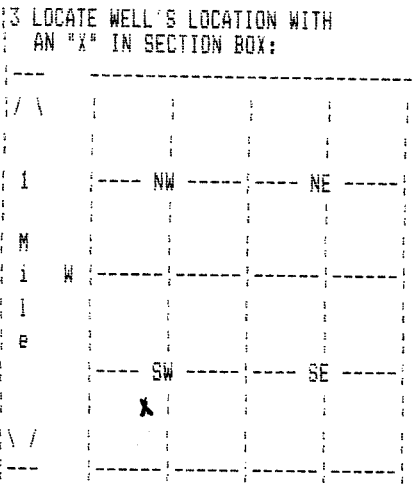

4 DEPTH OF COMPLETED WELL 164 ELEVATION: 0  
 Depth(s) Groundwater Encountered 1. 141 ft. 2. 0 ft. 3. 0 ft.  
 WELL'S STATIC WATER LEVEL 141 ft. below land surface measured on mo/day/yr 07/14/92  
 Pump testdata: Well water was 0 ft. after 0 hours pumping 0 gpm  
 Estimated Yield 0 gpm; Well water was 0 ft. after 0 hours pumping 0 gpm  
 Bore Hole Diameter 9.875 in. to 164 ft., and in. to 0 ft.  
 WELL WATER TO BE USED AS: 12 OTHER  
 Was a chemical/bacteriological sample submitted to department? No;  
 If yes, mo/day/yr sample was submitted Water well disinfected? Yes

5 TYPE OF BLANK CASING USED: 02 PVC CASING JOINTS: GLUED  
 Blank casing diameter 5 in. to 164 ft., Dia in. to 0 ft., Dia in. to 0 ft.  
 Casing height above land surface 12 in., weight 3 lbs/ft. Wall thickness or gauge No. .265  
 TYPE OF SCREEN OR PERFORATION MATERIAL: 07 PVC  
 SCREEN OR PERFORATION OPENINGS ARE: 03 MILL SLOT  
 SCREEN PERFORATED INTERVALS: From 134 ft. to 164 ft., From 0 ft. to 0 ft.  
 GRAVEL PACK INTERVALS: From 0 ft. to 0 ft., From 0 ft. to 0 ft.  
 From 20 ft. to 164 ft., From 0 ft. to 0 ft.  
 From 0 ft. to 0 ft., From 0 ft. to 0 ft.

6 GROUT MATERIAL 03 BENTONITE  
 Grout Intervals: From 0 ft. to 20 ft., From 0 ft. to 0 ft., From 0 ft. to 0 ft.  
 What is the nearest source of possible contamination: NONE OBSERVED  
 Direction from well? How many feet? 0

FROM	TO	LITHOLOGIC LOG	FROM	TO	PLUGGING INTERVALS
0	1	01 CLAY			
1	10	04 SANDY CLAY 31 CALICHE			
10	12	04 SANDY CLAY			
12	55	07 FINE SAND 08 MEDIUM SAND 01 CLAY			
55	57	04 SANDY CLAY			
57	75	07 FINE SAND 08 MEDIUM SAND 20 LIMESTONE			
75	80	05 SAND 20 LIMESTONE 28 ROCK			
80	85	01 CLAY			
85	116	08 MEDIUM SAND 13 FINE GRAVEL 28 ROCK			
116	118	04 SANDY CLAY			

7 CONTRACTOR'S OR LANDOWNER'S CERTIFICATION: This water well was Constructed under my jurisdiction and was completed on (mo/day/year) 07/17/92 and this record is true to the best of my knowledge and belief, Kansas Water Well Contractor's License No. 145 This Water Well Record was completed on (mo/day/yr) 10/08/92 under the business name of HENKLE DRILLING & SUPPLY by (signature) Douglas B. Henkle

1 LOCATION OF WATER WELL:	Fraction	Section Number	Township Number	Range Number
COUNTY: 038 HAMILTON	NE 1/4 SW 1/4 SW 1/4	14	T 23 S	R 39 W

2 WATER WELL OWNER: HORTON, HARVEY  
 RR#, St. Address, Box #: NRR BOX 13A Board of Agriculture, Division of Water Resources  
 City, State, ZIP code: KENDALL, KS 67857- Application Number:

FROM	TO	LITHOLOGIC LOG
118	148	08 MEDIUM SAND 14 MED GRAVEL 28 ROCK
148	160	04 SANDY CLAY
160	168	08 MEDIUM SAND 20 LIMESTONE 28 ROCK
168	170	01 CLAY
170	172	19 SHALE

7 CONTRACTOR'S OR LANDOWNER'S CERTIFICATION: This water well was Constructed under my jurisdiction and was completed on (mo/day/year) 07/17/92 and this record is true to the best of my knowledge and belief. Kansas Water Well Contractor's License No. 145 This Water Well Record was completed on (mo/day/yr) 10/08/92 under the business name of HENKLE DRILLING & SUPPLY by (signature) *Douglas B. Henkle*