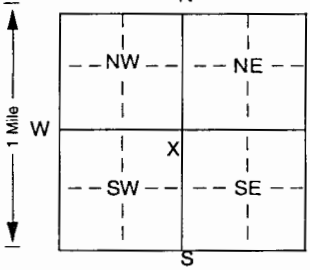
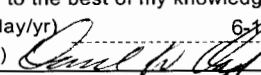


1 LOCATION OF WATER WELL:		Fraction		Section Number		Township Number		Range Number	
County: Reno		NE 1/4 NE 1/4 SW 1/4		9		T 23 S		R 4 E (W)	
Distance and direction from nearest town or city street address of well if located within city? Approximately 4 1/2 miles east of Hutchinson	
2 WATER WELL OWNER: Integra Commercial Realty, LLC RR#, St. Address, Box # c/o Lane Neville City, State, ZIP Code 8846 East Diamond Rim Drive Scottsdale, Arizona 85255	
Board of Agriculture, Division of Water Resources Application Number: 45,399	
3 LOCATE WELL'S LOCATION WITH AN "X" IN SECTION BOX:		4 DEPTH OF COMPLETED WELL 127 ft. ELEVATION: unknown	
		Depth(s) Groundwater Encountered 1 ft. 2 ft. 3 ft.	
		WELL'S STATIC WATER LEVEL 5 ft. below land surface measured on mo/day/yr 6-2-05	
		Pump test data: Well water was not checked ft. after hours pumping gpm	
		Est. Yield unknown gpm: Well water was ft. after hours pumping gpm	
		Bore Hole Diameter 38 in. to 126 ft., and in. to ft.	
WELL WATER TO BE USED AS: 1 Domestic 3 Feedlot 6 Oil field water supply 9 Dewatering 12 Other (specify below) (2) Irrigation 4 Industrial 7 Domestic (lawn & garden) 10 Monitoring well	
Was a chemical/bacteriological sample submitted to Department? Yes No <input checked="" type="checkbox"/> If yes, mo/day/yr sample was submitted Water Well Disinfected? Yes No <input checked="" type="checkbox"/>	
5 TYPE OF BLANK CASING USED: (1) Steel 3 RMP (SR) 5 Wrought iron 8 Concrete tile CASING JOINTS: Glued Clamped (2) PVC 4 ABS 6 Asbestos-Cement 9 Other (specify below) Bolted <input checked="" type="checkbox"/> Welded 7 Fiberglass Threaded Blank casing diameter 12 3/4 (steel) in. to 30 ft., Dia 12 3/4 (PVC) in. to 40 ft., Dia in. to ft. Casing height above land surface 24 in., weight 49.56 (steel) 10.31 (PVC) lbs./ft. Wall thickness or gauge No. 375 (steel) 420 (PVC)	
TYPE OF SCREEN OR PERFORATION MATERIAL: 1 Steel (3) Stainless steel 5 Fiberglass 8 RMP (SR) 10 Asbestos-cement 2 Brass 4 Galvanized steel 6 Concrete tile 9 ABS 11 Other (specify) 12 None used (open hole)	
SCREEN OR PERFORATION OPENINGS ARE: (1) Continuous slot (3) Mill slot 5 Gauzed wrapped 8 Saw cut 11 None (open hole) 2 Louvered shutter 4 Key punched 6 Wire wrapped 9 Drilled holes 7 Torch cut 10 Other (specify) ft.	
SCREEN-PERFORATED INTERVALS: From 40 - 60 (PVC) ft. to 70 - 78 (PVC) ft., From 88 - 110 (PVC) ft. to 115 - 125 (PVC) ft. From 60 - 70 (S.S.) ft. to 78 - 88 (S.S.) ft., From 110 - 115 (S.S.) ft. to ft.	
GRAVEL PACK INTERVALS: From 34 ft. to 126 ft., From ft. to ft.	
6 GROUT MATERIAL: 1 Neat cement (2) Cement grout 3 Bentonite 4 Other Bentonite holeplug Compacted Soil Grout Intervals: From 0 ft. to 5 ft., From 5 ft. to 25 ft., From 25 ft. to 34 ft. What is the nearest source of possible contamination: 1 Septic tank 4 Lateral lines 7 Pit privy 10 Livestock pens 14 Abandoned water well 2 Sewer lines 5 Cess pool 8 Sewage lagoon 11 Fuel storage 15 Oil well/Gas well 3 Watertight sewer lines 6 Seepage pit 9 Feedyard 12 Fertilizer storage 16 Other (specify below) 13 Insecticide storage None known Direction from well? How many feet?	
<table border="1" style="width:100%; border-collapse: collapse;"><thead><tr><th>FROM</th><th>TO</th><th>LITHOLOGIC LOG</th><th>FROM</th><th>TO</th><th>PLUGGING INTERVALS</th></tr></thead><tbody><tr><td>0</td><td>1</td><td>Topsoil</td><td></td><td></td><td></td></tr><tr><td>1</td><td>15</td><td>Clay, sandy with sand streaks</td><td></td><td></td><td></td></tr><tr><td>15</td><td>18</td><td>Sand, very fine</td><td></td><td></td><td></td></tr><tr><td>18</td><td>35</td><td>Clay, sandy, brown with sand, fine</td><td></td><td></td><td></td></tr><tr><td>35</td><td>50</td><td>Sand, very fine</td><td></td><td></td><td></td></tr><tr><td>50</td><td>80</td><td>Clay, sandy with sand, fine</td><td></td><td></td><td></td></tr><tr><td>80</td><td>90</td><td>Sand, very fine with clay</td><td></td><td></td><td></td></tr><tr><td>90</td><td>105</td><td>Clay, with sand, fine</td><td></td><td></td><td></td></tr><tr><td>105</td><td>118</td><td>Sand, very fine</td><td></td><td></td><td></td></tr><tr><td>118</td><td>126</td><td>Clay with sand, very fine</td><td></td><td></td><td></td></tr><tr><td></td><td></td><td></td><td></td><td></td><td></td></tr><tr><td></td><td></td><td></td><td></td><td></td><td></td></tr><tr><td></td><td></td><td></td><td></td><td></td><td></td></tr><tr><td></td><td></td><td></td><td></td><td></td><td></td></tr>
7 CONTRACTOR'S OR LANDOWNER'S CERTIFICATION: This water well was (1) constructed (2) reconstructed or (3) plugged under my jurisdiction and was completed on (mo/day/year) 6-2-05 and this record is true to the best of my knowledge and belief. Kansas Water Well Contractor's License No 185 This Water Well Record was completed on (mo/day/yr) 6-11-05 under the business name of Clarke Well & Equipment, Inc. by (signature) 	
INSTRUCTIONS: Use typewriter or ball point pen. PLEASE PRESS FIRMLY and PRINT clearly. Please fill in blanks, underline or circle the correct answers. Send top three copies to Kansas Department of Health and Environment, Bureau of Water, Topeka, Kansas 66620-0001. Telephone 785-296-5524. Send one to WATER WELL OWNER and retain one for your records. Fee of \$5.00 for each constructed well.	