Darling Drilling Co.

Residence Phone 662-3991

1211 W. 4th
Hutchinson, Kansas 67501

Office Phone 662-7901

DRILLER'S TEST LOG

Customer's Name: Dave McKinne Date: 10-9-79

Address: Hutch KS Test No.: House well

County: Reno Quarter: SE/SW Section: 6 Township: 23 Range: 4W

DRILLED FOOTAGE From	To	DESCRIPTION OF STRATA
0	3	T.S.
3	17	Clay
17	19	Sandy streak
19	25	Clay
25	27	Sandy streak
27	42	Fine
42	55	Clay
55	63	Sandy streak
63	67	Clay
67	85	Fine Sand
		13 ft unsat. silt & clay

Indicate Test Location By an X

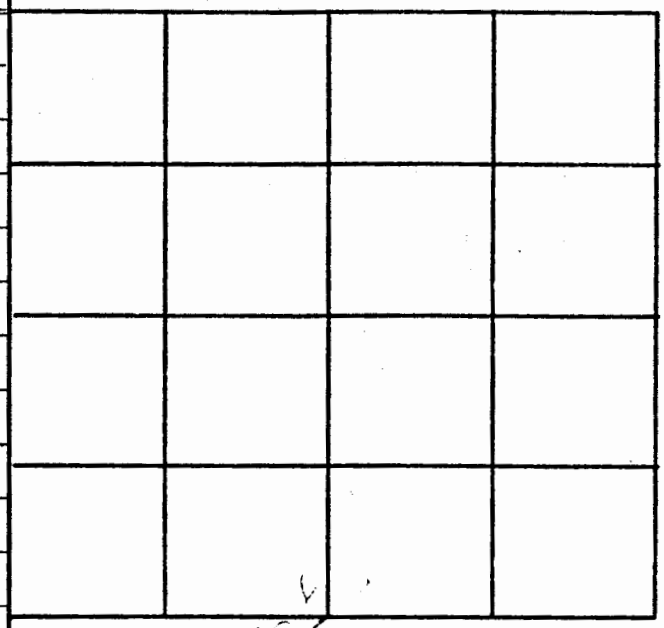

Static Water Level: 13'

REMARKS: 5" casing Domestic
20' Perf Test pump
1½ pump 20GPM