WATER WELL PLUGGING RECORD Form WWC-5P KSA 82a-1212 ID NO. _____

1 LOCATION OF WATER WELL:	Fraction	Section Number	Township Number	Range Number
County: Reno	NE¼ NE ¼ SE ¼	27	26	4 W

Distance and direction from nearest town or city street address of well if located within city?
1/2 mile North of St. Joe, Ks.

2 WATER WELL OWNER: Fahrenheit Heating & Cooling c/o Bruce Hobbs
RR #, St. Address, Box #: 1227 W. McCormick
City, State, ZIP Code : Wichita, Ks. 67213
Board of Agriculture, Division of Water Resources
Application Number:

3 MARK WELL'S LOCATION WITH AN "X" IN SECTION BOX:

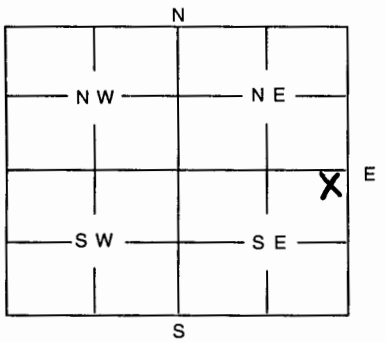

4 DEPTH OF WELL 5 @200 ft

WELL'S STATIC WATER LEVEL 60 ft.

WELL WAS USED AS:

1 Domestic	5 Public Water Supply	9 Dewatering
2 Irrigation	6 Oil Field Water Supply	10 Monitoring Well
3 Feedlot	7 Domestic (Lawn & Garden)	11 Injection Well
4 Industrial	8 Air Conditioning	12 X Other heatpump

Was a chemical / bacteriological sample submitted to Department? Yes ..... No X
If yes, mo/day/yr sample was submitted .....

Water Well Disinfected: Yes ..... No X

5 TYPE OF BLANK CASING USED:

1 Steel	3 RMP (SR)	5 Wrought	7 Fiberglass	X Other (Specify below)
2 PVC	4 ABS	6 Asbestos-Cement	8 Concrete Tile	polyethylene

Blank casing diameter 3/4 in. Was casing pulled? Yes ..... No ..... If yes, how much .....
Casing height above or below land surface ..... in.

6 GROUT PLUG MATERIAL: 1 Neat cement 2 Cement grout X Bentonite 4 Other .....

Grout Plug Intervals: From 3 ft. to 200 ft., From 3 ft. to 200 ft., From 3 to 200 ft.
From 3 ft to 200 ft, From 3 ft to 200 ft

What is the nearest source of possible contamination:

1 Septic tank	6 Seepage pit	11 Fuel storage	16 Other (specify below)
2 Sewer lines	7 Pit privy	12 Fertilizer storage	.....
3 Watertight sewer lines	8 Sewage lagoon	13 Insecticide storage	
X Lateral lines	9 Feedyard	14 Abandoned water well	
5 Cess Pool	10 Livestock pens	15 Oil well/Gas well	

Direction from well? South How many feet? 100 ft

FROM	TO	PLUGGING MATERIALS
0	27	Clay, tan
27	40	Shale, gray
40	43	Shale, fractured (dry)
43	90	Shale, gray
90	95	Shale, fractured, wet
95	115	Shale, gray
115	116	Shale, fractured

116 to 200 Shale, gray

7 CONTRACTOR'S OR LANDOWNER'S CERTIFICATION: This water well was plugged under my jurisdiction and was completed on (mo/day/year) 1/10/06 and this record is true to the best of my knowledge and belief. Kansas Water Well Contractor's License No. 138 This Water Well Record was completed on (mo/day/year) 1/26/06 under the business name of Peterson Irrigation, Inc.
by (signature) Mike Peterson

INSTRUCTIONS: Use typewriter or ball point pen. Please press firmly and print clearly. Please fill in blanks, underline or circle the correct answers. Send top three copies to Kansas Department of Health and Environment, Bureau of Water, Topeka, Kansas 66620-0001. Telephone: 785/296-3565. Send one to Water Well Owner and retain one for your records.