


WATER WELL RECORD Form WWC-5 KSA 82a-1212

1 LOCATION OF WATER-WELL: Fraction Section Number Township Number Range Number
 COUNTY: HAMILTON NW 1/4 SE 1/4 SE 1/4 29 T 23 S R 40 W

Distance and direction from nearest town or city street address of well if located within city?
 SYRACUSE - 1 EAST ON HIGHWAY 50 3 1/2 NORTH & 1/4 WEST

2 WATER WELL OWNER: MITCELL, KERSTIN Board of Agriculture, Division of Water Resources
 RR#, St. Address, Box #: BOX 75 Application Number:
 City, State, ZIP code: SYRACUSE, KS 67878-

3 LOCATE WELL'S LOCATION WITH AN "X" IN SECTION BOX:

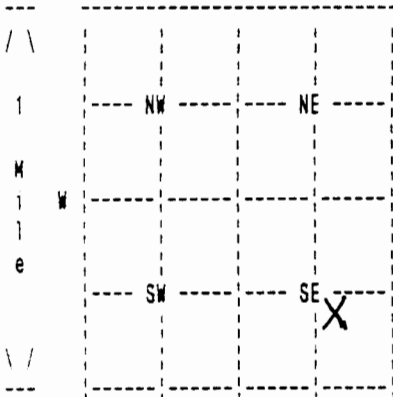

4 DEPTH OF COMPLETED WELL 455 ELEVATION: 0
 Depth(s) Groundwater Encountered 1. 0 ft. 2. 0 ft. 3. 0 ft.
 WELL'S STATIC WATER LEVEL 325 ft. below land surface measured on mo/day/yr 05/12/07
 Pump testdata: Well water was 0 ft. after 0 hours pumping 0 gpm
 Estimated Yield 25 gpm: Well water was 0 ft. after 0 hours pumping 0 gpm
 Bore Hole Diameter 9 in. to 455 ft., and in. to 0 ft.
 WELL WATER TO BE USED AS: DOMESTIC
 Was a chemical/bacteriological sample submitted to department? No ;
 If yes, mo/day/yr sample was submitted Water well disinfected? Yes

5 TYPE OF BLANK CASING USED: CERTA LOC CASIN CASING JOINTS: CERTA-LOC
 Blank casing diameter 5 in. to 455 ft., Dia in. to 0 ft., Dia in. to 0 ft.
 Casing height above land surface 12 in., weight 200 lbs/ft. Wall thickness or gauge No. 21 17
 TYPE OF SCREEN OR PERFORATION MATERIAL: PVC
 SCREEN OR PERFORATION OPENINGS ARE: SAW CUT

SCREEN PERFORATED INTERVALS: From 390 ft. to 450 ft., From 0 ft. to 0 ft.
 From 0 ft. to 0 ft., From 0 ft. to 0 ft.
 GRAVEL PACK INTERVALS: From 15 ft. to 100 ft., From 0 ft. to 0 ft.
 From 126 ft. to 455 ft., From 0 ft. to 0 ft.

6 GROUT MATERIAL BENTONITE
 Grout Intervals: From 6 ft. to 15 ft., From 100 ft. to 126 ft., From 0 ft. to 0 ft.
 What is the nearest source of possible contamination: ABANDONED WELL
 Direction from well? NORTH How many feet? 40

FROM	TO	LITHOLOGIC LOG	FROM	TO	PLUGGING INTERVALS
0	20	01 TOPSOIL 05 CLAY 37 FIN-COAR SAN			
20	80	37 FIN-COAR SAN 38 SMAL-MED GRA			
80	320	07 BLUE SHALE 24 THINROCLAYER			
320	440	29 SANDSTONE			
440	460	36 BLUE CLAY 07 BLUE SHALE			

7 CONTRACTOR'S OR LANDOWNER'S CERTIFICATION: This water well was Constructed under my jurisdiction and was completed on (mo/day/year) 05/13/07 and this record is true to the best of my knowledge and belief. Kansas Water Well Contractor's License No. 179 This Water Well Record was completed on (mo/day/yr) 05/25/07 under the business name of JOE'S WELL SERVICE, INC. by (signature) *Justin Creek*