


WATER WELL RECORD Form WWC-5 KSA 82a-1212

1 LOCATION OF WATER WELL: Fraction Section Number Township Number Range Number  
 COUNTY: HAMILTON SW 1/4 SW 1/4 SE 1/4 3 T 23 S R 40 W

Distance and direction from nearest town or city street address of well if located within city?  
 FROM SYRACUSE - 1 E TO RD. 0 - 7 N. TO 14 RD 1 1/2

2 WATER WELL OWNER: BEZONA, BOYD Board of Agriculture, Division of Water Resources  
 RR#, St. Address, Box #: BOX 687 Application Number:  
 City, State, ZIP code: SYRACUSE, KS 67878-

3 LOCATE WELL'S LOCATION WITH AN "X" IN SECTION BOX:

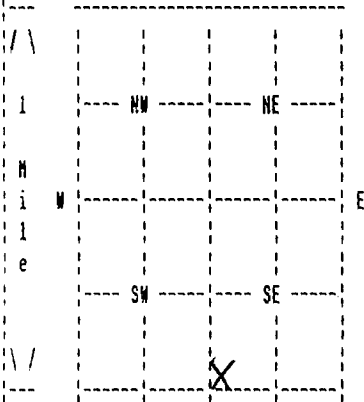

4 DEPTH OF COMPLETED WELL 150 ELEVATION: 0  
 Depth(s) Groundwater Encountered 1. 0 ft. 2. 0 ft. 3. 0 ft.

WELL'S STATIC WATER LEVEL <sup>118</sup> 135 ft. below land surface measured on mo/day/yr 08/25/10  
 Pump test data: Well water was 0 ft. after 0 hours pumping 0 gpm

Estimated Yield 20 gpm: Well water was 0 ft. after 0 hours pumping 0 gpm

Bore Hole Diameter 10 in. to 150 ft., and in. to 0 ft.

WELL WATER TO BE USED AS: DOMESTIC

Was a chemical/bacteriological sample submitted to department? No ;  
 If yes, mo/day/yr sample was submitted Water well disinfected? Yes

5 TYPE OF BLANK CASING USED: CERTA LOC CASIN CASING JOINTS: CERTA-LOC  
 Blank casing diameter 5 in. to 150 ft., Dia in. to 0 ft., Dia in. to 0 ft.  
 Casing height above land surface 12 in., weight 200 lbs/ft. Wall thickness or gauge No. 21  
 TYPE OF SCREEN OR PERFORATION MATERIAL: PVC  
 SCREEN OR PERFORATION OPENINGS ARE: SAW CUT

SCREEN PERFORATED INTERVALS: From 120 ft. to 150 ft., From 0 ft. to 0 ft.  
 From 0 ft. to 0 ft., From 0 ft. to 0 ft.  
 GRAVEL PACK INTERVALS: From 20 ft. to 150 ft., From 0 ft. to 0 ft.  
 From 0 ft. to 0 ft., From 0 ft. to 0 ft.

6 GROUT MATERIAL BENTONITE  
 Grout Intervals: From 5 ft. to 25 ft., From 0 ft. to 0 ft., From 0 ft. to 0 ft.  
 What is the nearest source of possible contamination: ABANDONED WELL  
 Direction from well? WEST How many feet? 15

FROM	TO	LITHOLOGIC LOG	FROM	TO	PLUGGING INTERVALS
0	20	01 TOPSOIL 05 CLAY 02 FINE SAND			
20	40	02 FINE SAND			
40	60	10 FINE-MEDSAND 04 COARSE SAND			
60	80	37 FIN-COAR SAN 06 SMALL GRAVEL			
80	100	37 FIN-COAR SAN 38 SHAL-MED GRA			
100	120	37 FIN-COAR SAN			
120	145	37 FIN-COAR SAN 06 SMALL GRAVEL			
145	150	32 TAN CLAY			
150	160	07 BLUE SHALE			

7 CONTRACTOR'S OR LANDOWNER'S CERTIFICATION: This water well was Constructed under my jurisdiction and was completed on (mo/day/year) 08/26/10 and this record is true to the best of my knowledge and belief. Kansas Water Well Contractor's License No. 179 This Water Well Record was completed on (mo/day/yr) 09/20/10 under the business name of JOE'S WELL SERVICE, INC. by (signature) *Judith Cuck*