

County: Hamilton Fraction SW-NW Sec. 6 T 23 S R 40 E/W

CORRECTION(S) TO WATER WELL COMPLETION RECORD (WWC-5)

(to rectify lacking or incorrect information)

Owner: Herrman, Henry

Location was listed as:

Location changed to:

Section-Township-Range: _____

Fraction (1/4 1/4 1/4): None

SW-NW

Other changes: Initial statements: Feedlot

Changed to: Domestic - Livestock

Comments: _____


Verification method: Quarter Section Based on Location Map on Form, Use Changed by
Looking at Aerial Image in pasture with No Feedlot Around.

initials: DF date: 5/12/14

Submitted by: Kansas Geological Survey, Data Resources Library, 1930 Constant Ave., Lawrence, KS 66047-3726
to: Kansas Dept of Health & Environment, Bureau of Water, 1000 SW Jackson, Suite 420, Topeka, KS 66612-1367.

1 LOCATION OF WATER WELL: Fraction $\frac{1}{4}$ $\frac{1}{4}$ $\frac{1}{4}$ Section Number 6 Township Number T 23 S Range Number R 40 E/W
 County: _____ Distance and direction from nearest town or city street address of well if located within city? _____

2 WATER WELL OWNER: Henry Herrman **Global Positioning Systems** (decimal degrees, min. of 4 digits)
 RR#, St. Address, Box #: 708 Latitude: _____
 City, State ZIP Code: Syracuse Kansas 67878 Longitude: _____
 Elevation: _____
 Datum: _____
 Data Collection Method: _____

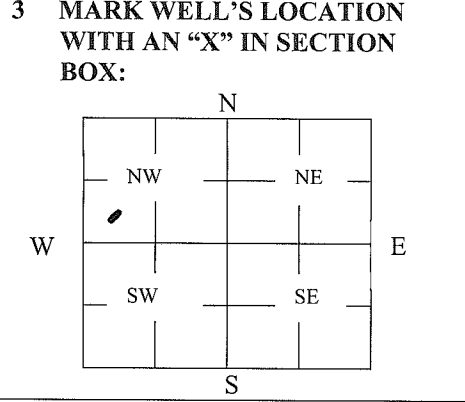

4 DEPTH OF WELL 41 ft.
 WELL'S STATIC WATER LEVEL 24 ft.
 WELL WAS USED AS:
 1 Domestic 5 Public Water Supply 9 Dewatering
 2 Irrigation 6 Oil Field Water Supply 10 Monitoring
 3 Feedlot 7 Domestic (Lawn & Garden) 11 Injection Well
 4 Industrial 8 Air Conditioning 12 Other _____
 Was a chemical/bacteriological sample submitted to Department? Yes _____ No

5 TYPE OF BLANK CASING USED:
 1 Steel 3 RMP (SR) 5 Wrought 7 Fiberglass 9 Other (Specify below)
 2 PVC 4 ABS 6 Asbestos-Cement 8 Concrete Tile
 Blank casing diameter 4 in. Was casing pulled? Yes _____ No If yes, how much _____
 Casing height above or below land surface 42 in.

6 GROUT PLUG MATERIAL: 1 Neat cement 2 Cement grout 3 Bentonite 4 Other _____
 Grout Plug Intervals: From 11 ft. to 8 ft., From _____ ft. to _____ ft., From _____ to _____ ft.
 What is the nearest source of possible contamination:
 1 Septic tank 6 Seepage pit 11 Fuel Storage 16 Other (specify below)
 2 Sewer lines 7 Pit privy 12 Fertilizer storage
 3 Watertight sewer lines 8 Sewage lagoon 13 Insecticide storage
 4 Lateral lines 9 Feedyard 14 Abandoned water well Direction from well? North East
 5 Cess pool 10 Livestock pens 15 Oil well/Gas well How many feet? 150'

| FROM | TO | PLUGGING MATERIALS | FROM | TO | PLUGGING MATERIALS |
|------------|---------------|-------------------------|------|----|--------------------|
| <u>41'</u> | <u>22'</u> | <u>40oz Bleach Sand</u> | | | |
| <u>22'</u> | <u>11'</u> | <u>Clay Dirt</u> | | | |
| <u>11'</u> | <u>8"</u> | <u>Bentonite</u> | | | |
| <u>8'</u> | <u>5'</u> | <u>Cement</u> | | | |
| <u>5'</u> | <u>Ground</u> | <u>Clay Dirt</u> | | | |
| | | | | | |
| | | | | | |

7 CONTRACTOR'S OR LANDOWNER'S CERTIFICATION: This water well was plugged under my jurisdiction and was completed on (mo/day/year) 4-14-2014 and this record is true to the best of my knowledge and belief. Kansas Water Well Contractor's License No. _____. This Water Well Record was completed on (mo/day/year) 4-14-2014 under the business name of The Hub of Syracuse by (signature) Garland Smith

INSTRUCTIONS: Use typewriter or ballpoint pen. Please press firmly and print clearly. Please fill in blanks, underline or circle the correct answers. Send top three copies to Kansas Department of Health and Environment, Bureau of Water, Geology Section, 1000 SW Jackson St., Ste. 420, Topeka, Kansas 66612-1367. Telephone: 785/296-5522. Send one to Water Well Owner and retain one for your records. Visit us at <http://www.kdheks.gov/geo/waterwells>.