


1 LOCATION OF WATER WELL: County: Hamilton Fraction: SE 1/4 SW 1/4 SW 1/4 Section Number: 13 Township Number: T 23 S Range Number: R 41 ~~22W~~

Distance and direction from nearest town or city street address of well if located within city?
4 North, 1/2 West of Syracuse, Kansas

2 WATER WELL OWNER: Paul Wilcoxon
 RR#, St. Address, Box #: Star Route Board of Agriculture, Division of Water Resources
 City, State, ZIP Code: Syracuse, Kansas 67878 Application Number: ----

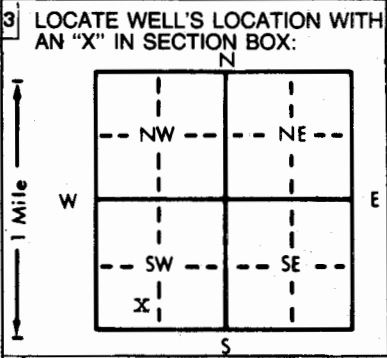

4 DEPTH OF COMPLETED WELL: 320 ft. ELEVATION: Slope
 Depth(s) Groundwater Encountered: 1. Not available ft. 2. ft. 3. ft.
 WELL'S STATIC WATER LEVEL: 24 ft. below land surface measured on mo/day/yr June 24, 1981
 Pump test data: Well water was ft. after hours pumping gpm
 Est. Yield .15 gpm: Well water was ft. after hours pumping gpm
 Bore Hole Diameter: 9. 7/8 in. to .320 ft., and in. to ft.
 WELL WATER TO BE USED AS:
 5 Public water supply 8 Air conditioning 11 Injection well
 1 Domestic 3 Feedlot 6 Oil field water supply 9 Dewatering XX2 Other (Specify below)
 2 Irrigation 4 Industrial 7 Lawn and garden only 10 Observation well Stock
 Was a chemical/bacteriological sample submitted to Department? Yes.....No.....XX; If yes, mo/day/yr sample was submitted
 Water Well Disinfected? Yes XXX No

5 TYPE OF BLANK CASING USED:
 1 Steel 3 RMP (SR) 5 Wrought iron 8 Concrete tile CASING JOINTS: Glued XX Clamped
XXX PVC 4 ABS 6 Asbestos-Cement 9 Other (specify below) Welded
 7 Fiberglass Threaded
 Blank casing diameter: .5 in. to .100 ft., Dia in. to ft., Dia in. to ft.
 Casing height above land surface: .12 in., weight 2.8 lbs./ft. Wall thickness or gauge No. .265
 TYPE OF SCREEN OR PERFORATION MATERIAL:
 1 Steel 3 Stainless steel 5 Fiberglass XX PVC 10 Asbestos-cement
 2 Brass 4 Galvanized steel 6 Concrete tile 9 ABS 11 Other (specify)
 12 None used (open hole)
 SCREEN OR PERFORATION OPENINGS ARE:
 5 Gauzed wrapped XXX8 Saw cut 11 None (open hole)
 1 Continuous slot 3 Mill slot 6 Wire wrapped 9 Drilled holes
 2 Louvered shutter 4 Key punched 7 Torch cut 10 Other (specify)
 SCREEN-PERFORATED INTERVALS: From .100 ft. to .320 ft., From ft. to ft.
 From ft. to ft., From ft. to ft.
 GRAVEL PACK INTERVALS: From .14 ft. to .320 ft., From ft. to ft.
 From ft. to ft., From ft. to ft.

6 GROUT MATERIAL: XXX Neat cement 2 Cement grout 3 Bentonite 4 Other
 Grout Intervals: From .4 ft. to .14 ft., From ft. to ft., From ft. to ft.
 What is the nearest source of possible contamination:
 1 Septic tank 4 Lateral lines 7 Pit privy 10 Livestock pens 14 Abandoned water well
 2 Sewer lines 5 Cess pool 8 Sewage lagoon 11 Fuel storage XX15 Oil well Gas well
 3 Watertight sewer lines 6 Seepage pit 9 Feedyard 12 Fertilizer storage 16 Other (specify below)
 13 Insecticide storage
 Direction from well? Northeast How many feet? 2700

FROM	TO	LITHOLOGIC LOG	FROM	TO	LITHOLOGIC LOG
0	1	Topsoil			
1	20	Clay			
20	300	Blue Clay			
300	330	Dakota Sandstone			

7 CONTRACTOR'S OR LANDOWNER'S CERTIFICATION: This water well was (1) constructed, (2) reconstructed, or (3) plugged under my jurisdiction and was completed on (mo/day/year) June 24, 1981 and this record is true to the best of my knowledge and belief. Kansas Water Well Contractor's License No. 252 This Water Well Record was completed on (mo/day/year) June 29, 1981 under the business name of Friesen Windmill & Supply Inc. by (signature) [Signature]

INSTRUCTIONS: Use typewriter or ball point pen, PLEASE PRESS FIRMLY and PRINT clearly. Please fill in blanks, underline or circle the correct answers. Send top three copies to Kansas Department of Health and Environment, Division of Environment, Environmental Geology Section, Topeka, KS 66620. Send one to WATER WELL OWNER and retain one for your records.