

USE TYPEWRITER OR BALL POINT PEN-PRESS FIRMLY, PRINT CLEARLY.

T R EW sec 1/4 1/4 1/4 No.


WATER WELL RECORD
KSA 82a-1201-1215

Kansas State Dept. Of Health
(Water Well Contractors)
Forbes-Bldg. 740
Topeka, Kansas 66620

1 Location of well: County HAMILTON Township name Midway Fraction SE 1/4 - SW 1/4 Section number 33 Town number 23 Range number 41

Distance and direction from nearest town or city:
Street address of well location if in city:

3 Owner of well: John Tracy
Address: Syracuse

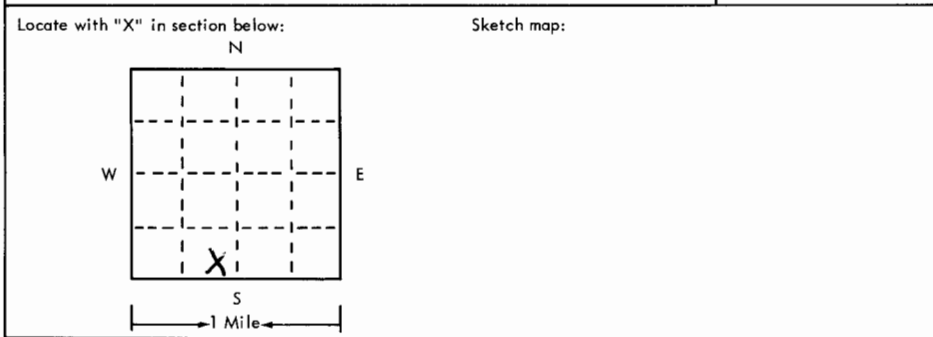

4 Well depth: 54 ft. Date of completion 5-24-75
Well diameter 16 in.

5 Cable tool Rotary Driven Dug
 Hollow rod Jetted Bored Reverse rotary

6 Use: Domestic Public supply Industry
 Irrigation Air conditioning Commercial
 Test well

7 Casing: Material Steel Height: above/below
Threaded Welded Surface 12 in.
Diam. Weight 39.30 lbs./ft.
12 in. to 34 ft. depth Drive shoe? Yes No
____ in. to ____ ft. depth

2	Type and color of material	From	To
	<u>CLAY</u>	<u>0</u>	<u>14</u>
	<u>SAND</u>	<u>14</u>	<u>18</u>
	<u>pea gravel - large Rock</u>	<u>18</u>	<u>54</u>

(use a second sheet if needed)

8 Screen:
Manufacturer Cook
Type Screen Dia. 16
Slot/gauze 100 Length _____
Set between 34 ft. and 54 ft.
Fittings:
Gravel pack Yes No Size range of material _____

9 Static water level:
18 ft. below land surface Date 5-24-75

10 Pumping level below land surfaces:
50 ft. after 4 hrs. pumping 800 g.p.m.
____ ft. after ____ hrs. pumping ____ g.p.m.
Estimated maximum yield 950 g.p.m.

11 Water sample submitted:
 Yes No Date _____

12 Well head completion:
 Pitless adapter _____ inches above grade

13 Well grouted? Yes No
 Neat cement Bentonite Surface
Depth: From 0 ft. to 10 ft.

14 Nearest source of possible contamination:
ft. _____ Direction _____ Type _____
Well disinfected upon completion? Yes No

15 Pump: Not installed
Manufacturer's name Could's
Model number _____ HP 60 Volts 440
Length of drop pipe 50 ft. capacity 800 g.m.p.
Type:
 Submersible Turbine
 Jet Reciprocating
 Centrifugal Other

16 Remarks: elevation

Topography:
 Hill
 Slope
 Upland
 Valley

17 Water well contractor's certification:
This well was drilled under my jurisdiction and this report is true to the best of my knowledge and belief.
Eaton Drilling Co 300
Business name License No.
Address PO Box 783
Signed Nathan Fulton 6-18-75
Authorized representative