


1 LOCATION OF WATER WELL: Fraction NW 1/4 NW 1/4 NW 1/4 Section Number 27 Township Number T 23 S Range Number R 42 EW

Distance and direction from nearest town or city street address of well if located within city? Approximately 9 miles West and 3 miles North of Syracuse, Ks.

2 WATER WELL OWNER: Doris Carter RR#, St. Address, Box #: P. O. Box 625 City, State, ZIP Code: Syracuse, Ks. 67878 Board of Agriculture, Division of Water Resources Application Number:

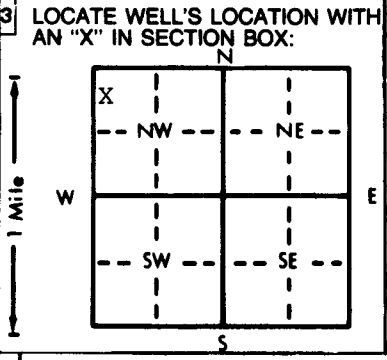

3 LOCATE WELL'S LOCATION WITH AN 'X' IN SECTION BOX: 4 DEPTH OF COMPLETED WELL: 191' ft. ELEVATION: Depth(s) Groundwater Encountered 1. 87' ft. 2. ft. 3. ft. WELL'S STATIC WATER LEVEL .87' ft. below land surface measured on mo/day/yr 6/30/88 Pump test data: Well water was ft. after hours pumping gpm Est. Yield .25 gpm: Well water was ft. after hours pumping gpm Bore Hole Diameter .9 7/8" in. to 191' ft., and in. to ft. WELL WATER TO BE USED AS: 5 Public water supply 8 Air conditioning 11 Injection well 1 Domestic 3 Feedlot 6 Oil field water supply 9 Dewatering 12 Other (Specify below) 2 Irrigation 4 Industrial 7 Lawn and garden only 10 Observation well Was a chemical/bacteriological sample submitted to Department? Yes No X; If yes, mo/day/yr sample was submitted Water Well Disinfected? Yes X No

5 TYPE OF BLANK CASING USED: 1 Steel 3 RMP (SR) 5 Wrought iron 8 Concrete tile CASING JOINTS: Glued X Clamped 2 PVC 4 ABS 6 Asbestos-Cement 9 Other (specify below) Welded 7 Fiberglass Threaded

Blank casing diameter 5 in. to 191' ft., Dia in. to ft., Dia in. to ft. Casing height above land surface 12 in., weight 2,902 lbs./ft. Wall thickness or gauge No. 265

TYPE OF SCREEN OR PERFORATION MATERIAL: 1 Steel 3 Stainless steel 5 Fiberglass 7 PVC 10 Asbestos-cement 2 Brass 4 Galvanized steel 6 Concrete tile 8 RMP (SR) 11 Other (specify) 9 ABS 12 None used (open hole)

SCREEN OR PERFORATION OPENINGS ARE: 1 Continuous slot 3 Mill slot 5 Gauzed wrapped 8 Saw cut 11 None (open hole) 2 Louvered shutter 4 Key punched 6 Wire wrapped 9 Drilled holes 7 Torch cut 10 Other (specify)

SCREEN-PERFORATED INTERVALS: From 191 ft. to 131 ft., From ft. to ft. GRAVEL PACK INTERVALS: From 20 ft. to 191 ft., From ft. to ft.

6 GROUT MATERIAL: 1 Neat cement 2 Cement grout 3 Bentonite 4 Other Grout Intervals: From 0 ft. to 20 ft., From 65 ft. to 70 ft., From ft. to ft.

What is the nearest source of possible contamination: 1 Septic tank 4 Lateral lines 7 Pit privy 10 Livestock pens 14 Abandoned water well 2 Sewer lines 5 Cess pool 8 Sewage lagoon 11 Fuel storage 15 Oil well/Gas well 3 Watertight sewer lines 6 Seepage pit 9 Feedyard 12 Fertilizer storage 16 Other (specify below) 13 Insecticide storage

Direction from well? West How many feet? 15'

Table with columns FROM, TO, LITHOLOGIC LOG, FROM, TO, LITHOLOGIC LOG. Row 1 contains 'See attached log'.

7 CONTRACTOR'S OR LANDOWNER'S CERTIFICATION: This water well was (1) constructed, (2) reconstructed, or (3) plugged under my jurisdiction and was completed on (mo/day/year) 6/15/88 and this record is true to the best of my knowledge and belief. Kansas Water Well Contractor's License No. 145 This Water Well Record was completed on (mo/day/yr) 7/6/88 under the business name of Henkle Drilling & Supply, Inc. by (signature) Bruce J. Reichmuth

