

WATER WELL PLUGGING RECORD Form WWC-5P


KSA 82a-1212

ID NO.

9018

1 LOCATION OF WATER WELL:
 County: HAMILTON Fraction SW 1/4 NW 1/4 SW 1/4 Section Number 19 Township Number 23S Range Number 42W E/W
 Distance and direction from nearest town or city street address of well if located within city?

2 WATER WELL OWNER: KEN BROWN
 RR#, St. Address, Box #: PO BOX 121
 City, State ZIP Code: COOLIDGE, KS. 67836
Global Positioning Systems (decimal degrees, min. of 4 digits)
 Latitude: _____
 Longitude: _____
 Elevation: _____
 Datum: _____
 Data Collection Method: _____

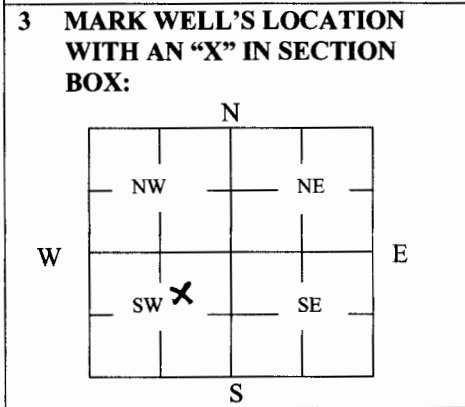

4 DEPTH OF WELL 72 ft.
 WELL'S STATIC WATER LEVEL 24 ft.
 WELL WAS USED AS:
 1 Domestic 5 Public Water Supply 9 Dewatering
 2 Irrigation 6 Oil Field Water Supply 10 Monitoring
 3 Feedlot 7 Domestic (Lawn & Garden) 11 Injection Well
 4 Industrial 8 Air Conditioning 12 Other _____
 Was a chemical/bacteriological sample submitted to Department? Yes _____ No

5 TYPE OF BLANK CASING USED:
 1 Steel 3 RMP (SR) 5 Wrought 7 Fiberglass 9 Other (Specify below) _____
 2 PVC 4 ABS 6 Asbestos-Cement 8 Concrete Tile _____
 Blank casing diameter 18 in. Was casing pulled? Yes _____ No If yes, how much _____
 Casing height above or below land surface -40" in.

6 GROUT PLUG MATERIAL: 1 Neat cement 2 Cement grout 3 Bentonite 4 Other _____
 Grout Plug Intervals: From _____ ft. to _____ ft., From _____ ft. to _____ ft., From _____ to _____ ft.
 What is the nearest source of possible contamination: -NO POSSIBLE CONTAMINATION
 1 Septic tank 6 Seepage pit 11 Fuel Storage 16 Other (specify below) _____
 2 Sewer lines 7 Pit privy 12 Fertilizer storage _____
 3 Watertight sewer lines 8 Sewage lagoon 13 Insecticide storage _____
 4 Lateral lines 9 Feedyard 14 Abandoned water well Direction from well? SOUTH-SOUTH WEST
 5 Cess pool 10 Livestock pens 15 Oil well/Gas well How many feet? 1500

FROM	TO	PLUGGING MATERIALS	FROM	TO	PLUGGING MATERIALS
15'	72'	SAND & GRAVEL MIX	0	3'	TOP SOIL CROWNED OVER WELL
4.0	15'	CLAY SOIL - COMPACTED			
3.5	40'	NEAT CEMENT PLUG			
3.0	3.5	CEMENT MUSHROOM			
		PLUG EXTENDING			
		1 FT. OUTSIDE CASING			
		& DOME ON TOP OF PLUG			

7 CONTRACTOR'S OR LANDOWNER'S CERTIFICATION: This water well was plugged under my jurisdiction and was completed on (mo/day/year) 2/25/2012 and this record is true to the best of my knowledge and belief. Kansas Water Well Contractor's License No. _____. This Water Well Record was completed on (mo/day/year) 2/26/2012 under the business name of KEN BROWN by (signature) [Signature]

INSTRUCTIONS: Use typewriter or ballpoint pen. Please press firmly and print clearly. Please fill in blanks, underline or circle the correct answers. Send top three copies to Kansas Department of Health and Environment, Bureau of Water, Geology Section, 1000 SW Jackson St., Ste. 420, Topeka, Kansas 66612-1367. Telephone: 785/296-5522. Send one to Water Well Owner and retain one for your records. Visit us at <http://www.kdheks.gov/geo/waterwells>.