


1 LOCATION OF WATER WELL: Fraction SW 1/4 NW 1/4 SW 1/4 Section Number 19 Township Number T 23 S Range Number R 42 EW
 County: HAMILTON

Distance and direction from nearest town or city street address of well if located within city?
2 mi. East Coolidge

2 WATER WELL OWNER: Ken Brown
 RR#, St. Address, Box #: Box 121 Board of Agriculture, Division of Water Resource
 City, State, ZIP Code: Coolidge, Ks. 67836 Application Number:

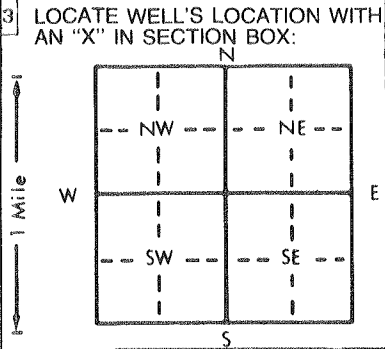

4 DEPTH OF COMPLETED WELL: 76 ft. ELEVATION: ft.
 Depth(s) Groundwater Encountered 1. 76 ft. 2. ft. 3. ft.
 WELL'S STATIC WATER LEVEL 26' 1" ft. below land surface measured on mo/day/yr 3-9-12
 Pump test data: Well water was ft. after hours pumping gpm
 Est. Yield 2000 gpm: Well water was ft. after hours pumping gpm
 Bore Hole Diameter: 28 in. to 76 ft., and in. to ft.
 WELL WATER TO BE USED AS:
 5 Public water supply 8 Air conditioning 11 Injection well
 1 Domestic 3 Feedlot 6 Oil field water supply 9 Dewatering 12 Other (Specify below)
2 Irrigation 4 Industrial 7 Lawn and garden only 10 Monitoring well
 Was a chemical/bacteriological sample submitted to Department? Yes..... No..... If yes, mo/day/yr sample was submitted
 Water Well Disinfected? Yes No

5 TYPE OF BLANK CASING USED:
 1 Steel 3 RMP (SR) 5 Wrought iron 8 Concrete tile CASING JOINTS: Glued Clamped
2 PVC 4 ABS 6 Asbestos-Cement 9 Other (specify below) Welded
 7 Fiberglass Threaded
 Blank casing diameter 16 in. to 76 ft., Dia in. to ft., Dia in. to ft.
 Casing height above land surface: 18 in., weight lbs./ft. Wall thickness or gauge No. 1/2
 TYPE OF SCREEN OR PERFORATION MATERIAL:
 1 Steel 3 Stainless steel 5 Fiberglass 7 PVC 10 Asbestos-cement
 2 Brass 4 Galvanized steel 6 Concrete tile 9 ABS 11 Other (specify)
 12 None used (open hole)
 SCREEN OR PERFORATION OPENINGS ARE:
 5 Gauzed wrapped 8 Saw cut 11 None (open hole)
 1 Continuous slot 3 Mill slot 6 Wire wrapped 9 Drilled holes
 2 Louvered shutter 4 Key punched 7 Torch cut 10 Other (specify)
 SCREEN-PERFORATED INTERVALS: From 76 ft. to 56 ft., From ft. to ft.
 From ft. to ft., From ft. to ft.
 GRAVEL PACK INTERVALS: From 76 ft. to 20 ft., From ft. to ft.
 From ft. to ft., From ft. to ft.

6 GROUT MATERIAL: 1 Neat cement 2 Cement grout 3 Bentonite 4 Other
 Grout Intervals: From 0 ft. to 20 ft., From ft. to ft., From ft. to ft.
 What is the nearest source of possible contamination:
 1 Septic tank 4 Lateral lines 7 Pit privy 10 Livestock pens 14 Abandoned water well
 2 Sewer lines 5 Cess pool 8 Sewage lagoon 11 Fuel storage 15 Oil well/Gas well
 3 Watertight sewer lines 6 Seepage pit 9 Feedyard 12 Fertilizer storage 16 Other (specify below)
 13 Insecticide storage

Direction from well? How many feet?

FROM	TO	LITHOLOGIC LOG	FROM	TO	PLUGGING INTERVALS
0	25	Top + Clay			Cement 0-20
25	73	Sand + gravel			
73	76	shale			

7 CONTRACTOR'S OR LANDOWNER'S CERTIFICATION: This water well was (1) constructed, (2) reconstructed, or (3) plugged under my jurisdiction and was completed on (mo/day/year) 3-16-12 and this record is true to the best of my knowledge and belief. Kansas Water Well Contractor's License No. 123 This Water Well Record was completed on (mo/day/yr) 5-9-12 under the business name of Ark Valley Pump & Supply by (signature) David S. Smith