


1 LOCATION OF WATER WELL: County: Hamilton	Fraction SE 1/4 SE 1/4 NW 1/4	Section Number 23	Township Number T 23 S	Range Number R 43 E/W (W)
--	---	-----------------------------	----------------------------------	--

Distance and direction from nearest town or city street address of well if located within city?
S. Hwy 50, Coolidge, Kansas

2 WATER WELL OWNER:
RR#, St. Address, Box # **Southeastern Colorado Coop Attn: James Harper** Board of Agriculture, Division of Water Resources
City, State, ZIP Code **Elm and Front Street, Coolidge, Ks 67836** Application Number: _____

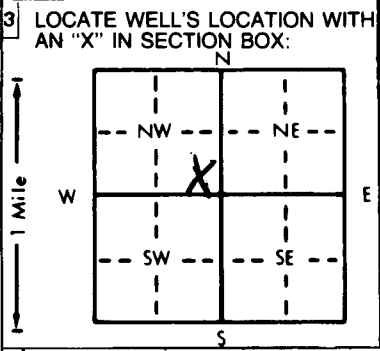

4 DEPTH OF COMPLETED WELL... **25** ft. ELEVATION: _____
 Depth(s) Groundwater Encountered 1... **18.2** ft. 2... _____ ft. 3... _____ ft.
 WELL'S STATIC WATER LEVEL... **18.84** ft. below land surface measured on mo/day/yr **12-11-96**
 Pump test data: Well water was _____ ft. after _____ hours pumping _____ gpm
 Est. Yield _____ gpm: Well water was _____ ft. after _____ hours pumping _____ gpm
 Bore Hole Diameter... **8.625** in. to **25** ft., and _____ in. to _____ ft.
 WELL WATER TO BE USED AS:
 5 Public water supply 8 Air conditioning 11 Injection well
 1 Domestic 3 Feedlot 6 Oil field water supply 9 Dewatering 12 Other (Specify below)
 2 Irrigation 4 Industrial 7 Lawn and garden only **10 Monitoring well** **mw-3**
 Was a chemical/bacteriological sample submitted to Department? Yes _____ No **X**; If yes, mo/day/yr sample was submitted _____
 Water Well Disinfected? Yes _____ No **X**

5 TYPE OF BLANK CASING USED:
 1 Steel 3 RMP (SR) 5 Wrought iron 8 Concrete tile CASING JOINTS: Glued _____ Clamped _____
 2 **PVC** 4 ABS 6 Asbestos-Cement 9 Other (specify below) Welded _____
 7 Fiberglass Threaded _____
 Blank casing diameter **2** in. to **25** ft., Dia _____ in. to _____ ft., Dia _____ in. to _____ ft.
 Casing height above land surface _____ in., weight **SCH 40 PVC** lbs./ft. Wall thickness or gauge No. _____
 TYPE OF SCREEN OR PERFORATION MATERIAL:
 1 Steel 3 Stainless steel 5 Fiberglass 8 RMP (SR) 10 Asbestos-cement
 2 Brass 4 Galvanized steel 6 Concrete tile 9 ABS 12 None used (open hole)
 SCREEN OR PERFORATION OPENINGS ARE:
 1 Continuous slot 3 Mill slot 5 Gauzed wrapped 8 Saw cut 11 None (open hole)
 2 Louvered shutter 4 Key punched 6 Wire wrapped 9 Drilled holes
 7 Torch cut 10 Other (specify) _____
 SCREEN-PERFORATED INTERVALS: From **25** ft. to **15** ft., From _____ ft. to _____ ft.
 From _____ ft. to _____ ft., From _____ ft. to _____ ft.
 SAND GRAVEL PACK INTERVALS: From _____ ft. to _____ ft., From _____ ft. to _____ ft.
 From **25** ft. to **14** ft., From _____ ft. to _____ ft.

6 GROUT MATERIAL: 1 Neat cement 2 Cement grout 3 Bentonite 4 Other _____
 Grout Intervals: **From 14 ft. to 12 ft. From 12 ft. to ground surface** From _____ ft. to _____ ft.
 What is the nearest source of possible contamination:
 1 Septic tank 4 Lateral lines 7 Pit privy 10 Livestock pens ~~14 Abandoned water well~~
 2 Sewer lines 5 Cess pool 8 Sewage lagoon 11 Fuel storage 15 Oil well/Gas well
 3 Watertight sewer lines 6 Seepage pit 9 Feedyard 12 Fertilizer storage 16 Other (specify below)
 13 Insecticide storage
 Direction from well? _____ How many feet? **Contaminated Si**

FROM	TO	LITHOLOGIC LOG	FROM	TO	PLUGGING INTERVALS
GL	1.00	Driveway sands, gravels, silts and clays			
	1.00	Silty Clay (CL)			
	17.50	Sand (SP)			
	17.50	Sand (SP)			
	25.00	End of Borehole			
	TD				

Flush Mount waiver
D. Taylor 10-24-96

7 CONTRACTOR'S OR LANDOWNER'S CERTIFICATION: This water well was **(1) constructed** (2) reconstructed, or (3) plugged under my jurisdiction and was completed on (mo/day/year) **12/10/96** and this record is true to the best of my knowledge and belief. Kansas Water Well Contractor's License No. **585** This Water Well Record was completed on (mo/day/yr) **12/20/96** under the business name of **AEI** by (signature) _____

OFFICE USE ONLY
T
R
EW
SEC.