


1 LOCATION OF WATER WELL: County: Hamilton Fraction 1/4 SW 1/4 SW 1/4 Section Number 14 Township Number T 23 S Range Number R 43 E/W

Distance and direction from nearest town or city street address of well if located within city?

North West corner of Coolidge

2 WATER WELL OWNER: City of Coolidge RR#, St. Address, Box #: Coolidge, Ka. City, State, ZIP Code: 67846 Board of Agriculture, Division of Water Resources Application Number:

3 LOCATE WELL'S LOCATION WITH AN "X" IN SECTION BOX: 4 DEPTH OF COMPLETED WELL: 340 ft. ELEVATION:

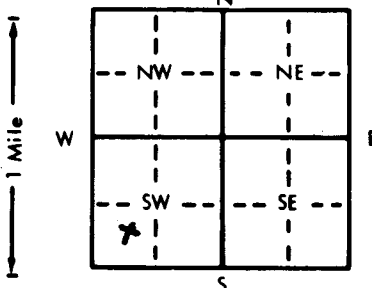

Depth(s) Groundwater Encountered 1. ft. 2. ft. 3. ft. WELL'S STATIC WATER LEVEL . . 86 ft. below land surface measured on mo/day/yr 10-20-83 Pump test data: Well water was . . 113 ft. after hours pumping . . 150 gpm Est. Yield . . 345 gpm: Well water was . . 140 ft. after hours pumping . . 345 gpm Bore Hole Diameter . . 1 7/8 in. to 340 ft., and in. to ft. WELL WATER TO BE USED AS: Public water supply 8 Air conditioning 11 Injection well 1 Domestic 3 Feedlot 6 Oil field water supply 9 Dewatering 12 Other (Specify below) 2 Irrigation 4 Industrial 7 Lawn and garden only 10 Observation well Was a chemical/bacteriological sample submitted to Department? Yes [X] No [] If yes, mo/day/yr sample was submitted Water Well Disinfected? Yes [X] No []

5 TYPE OF BLANK CASING USED: 1 Steel 3 RMP (SR) 5 Wrought iron 8 Concrete tile CASING JOINTS: Glued [X] Clamped [] 2 Brass 4 Galvanized steel 6 Asbestos-Cement 9 Other (specify below) Welded [] Threaded [] 3 PVC 4 ABS 7 Fiberglass

Blank casing diameter 8 in. to 270 ft., Dia 6.679 in. to ft., Dia in. to ft. Casing height above land surface 22 in., weight 6.679 lbs./ft. Wall thickness or gauge No.410

TYPE OF SCREEN OR PERFORATION MATERIAL: 1 Steel 3 Stainless steel 5 Fiberglass 8 RMP (SR) 10 Asbestos-cement 2 Brass 4 Galvanized steel 6 Concrete tile 9 ABS 11 Other (specify) 12 None used (open hole)

SCREEN OR PERFORATION OPENINGS ARE: 1 Continuous slot 3 Mill slot 5 Gauzed wrapped 8 Saw cut 11 None (open hole) 2 Louvered shutter 4 Key punched 6 Wire wrapped 9 Drilled holes 10 Other (specify) 7 Torch cut 10 Other (specify)

6 GROUT MATERIAL: Neat cement 2 Cement grout 3 Bentonite 4 Other Grout Intervals: From 0 ft. to 260 ft., From ft. to ft., From ft. to ft.

What is the nearest source of possible contamination: 1 Septic tank 4 Lateral lines 7 Pit privy 11 Fuel storage 14 Abandoned water well 2 Sewer lines 5 Cess pool 8 Sewage lagoon 12 Fertilizer storage 15 Oil well/Gas well 3 Watertight sewer lines 6 Seepage pit 9 Feedyard 13 Insecticide storage 16 Other (specify below) NA

Direction from well? FROM TO LITHOLOGIC LOG FROM TO LITHOLOGIC LOG

Test log attached

7 CONTRACTOR'S OR LANDOWNER'S CERTIFICATION: This water well was (1) constructed, (2) reconstructed, or (3) plugged under my jurisdiction and was completed on (mo/day/year) 10-20-83 and this record is true to the best of my knowledge and belief. Kansas Water Well Contractor's License No. 208 This Water Well Record was completed on (mo/day/yr) 2-3-84 under the business name of Minter Wilson Drilling Co. by (signature) P. H. Sessaman

INSTRUCTIONS: Use typewriter or ball point pen, PLEASE PRESS FIRMLY and PRINT clearly. Please fill in blanks, underline or circle the correct answers. Send top three copies to Kansas Department of Health and Environment, Division of Environment, Environmental Geology Section, Topeka, KS 66620. Send one to WATER WELL OWNER and retain one for your records.

