


WATER WELL RECORD Form WWC-5 KSA 82a-1212

1 LOCATION OF WATER WELL: Fraction Section Number Township Number Range Number  
 COUNTY: HAMILTON SW 1/4 NW 1/4 SE 1/4 27 T 23 S R 43 W

Distance and direction from nearest town or city street address of well if located within city?  
 COOLIDGE - SOUTH ON RD. B TO RD. 18 1/2 WEST 1/4 MILES NORTH

2 WATER WELL OWNER: *LOWE FARMS LLC - WELL #3*  
 RRB, St. Address, Box #: 1751 SW CO. RD. B Board of Agriculture, Division of Water Resources  
 City, State, ZIP code: COOLIDGE, KS 67836- Application Number:

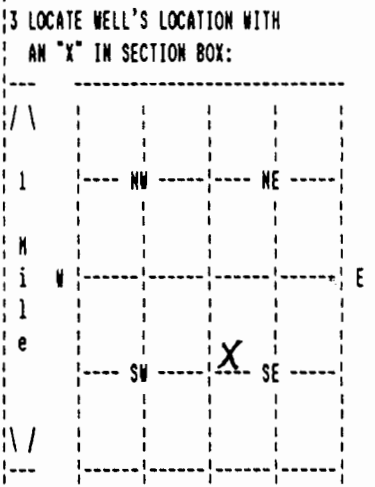

4 DEPTH OF COMPLETED WELL 193 ELEVATION: 3365  
 Depth(s) Groundwater Encountered 1. 0 ft. 2. 0 ft. 3. 0 ft.  
 WELL'S STATIC WATER LEVEL 36 ft. below land surface measured on mo/day/yr 05/05/11  
 Pump test data: Well water was 0 ft. after 0 hours pumping 0 gpa  
 Estimated Yield 30 gpa: Well water was 0 ft. after 0 hours pumping 0 gpa  
 Bore Hole Diameter 9 in. to 193 ft., and in. to 0 ft.  
 WELL WATER TO BE USED AS: DOMESTIC  
 Was a chemical/bacteriological sample submitted to department? No ;  
 If yes, mo/day/yr sample was submitted Water well disinfected? Yes

5 TYPE OF BLANK CASING USED: CERTA LOC CASIN CASING JOINTS: CERTA-LOC  
 Blank casing diameter 5 in. to 193 ft., Dia in. to 0 ft., Dia in. to 0 ft.  
 Casing height above land surface 12 in., weight 200 lbs/ft. Wall thickness or gauge No. 21  
 TYPE OF SCREEN OR PERFORATION MATERIAL: PVC  
 SCREEN OR PERFORATION OPENINGS ARE: SAW CUT

SCREEN PERFORATED INTERVALS: From 128 ft. to 188 ft., From 0 ft. to 0 ft.  
 From 0 ft. to 0 ft., From 0 ft. to 0 ft.  
 GRAVEL PACK INTERVALS: From 25 ft. to 193 ft., From 0 ft. to 0 ft.  
 From 0 ft. to 0 ft., From 0 ft. to 0 ft.

6 GROUT MATERIAL BENTONITE  
 Grout Intervals: From 6 ft. to 25 ft., From 50 ft. to 65 ft., From 0 ft. to 0 ft.  
 What is the nearest source of possible contamination: NONE  
 Direction from well? How many feet? 0

FROM	TO	LITHOLOGIC LOG	FROM	TO	PLUGGING INTERVALS
0	20	01 TOPSOIL 37 FIN-COAR SAN 38 SHAL-MED GRA			
20	40	37 FIN-COAR SAN 38 SHAL-MED GRA			
40	60	36 BLUE CLAY 24 THINROCLAYER			
60	80	36 BLUE CLAY 29 SANDSTONE			
80	100	29 SANDSTONE			
100	120	29 SANDSTONE 16 GRAY CLAY 19 LAYERS			
120	195	29 SANDSTONE			

7 CONTRACTOR'S OR LANDOWNER'S CERTIFICATION: This water well was Constructed under my jurisdiction and was completed on (mo/day/year) 05/06/11 and this record is true to the best of my knowledge and belief. Kansas Water Well Contractor's License No. 179 This Water Well Record was completed on (mo/day/yr) 05/31/11 under the business name of JOE'S WELL SERVICE, INC. by (signature) *Justin Creek*