


1 LOCATION OF WATER WELL: County: RENO Fraction: SE 1/4 SE 1/4 NW 1/4 Section Number: 7 Township Number: T 23 S Range Number: R 5 E/W

Distance and direction from nearest town or city street address of well if located within city?
111 S. Severance St, Hutchinson

2 WATER WELL OWNER: Adjacent General Dept - DOFE - E Attn. Major Andrew
 RR#, St. Address, Box #: 131 SW 27th, Topeka, KS 66601
 City, State, ZIP Code: 131 SW 27th, Topeka, KS 66601
 Board of Agriculture, Division of Water Resources Application Number: —

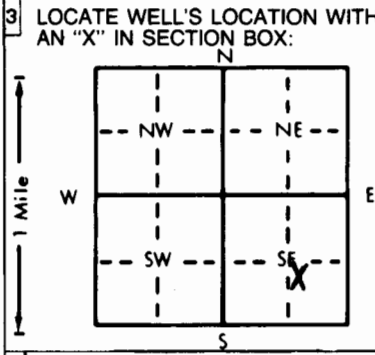

4 DEPTH OF COMPLETED WELL: 25 ft. ELEVATION: —
 Depth(s) Groundwater Encountered: 1. — ft. 2. — ft. 3. — ft.
 WELL'S STATIC WATER LEVEL: 14 ft. below land surface measured on mo/day/yr 7-25-95
 Pump test data: Well water was — ft. after — hours pumping — gpm
 Est. Yield — gpm Well water was — ft. after — hours pumping — gpm
 Bore Hole Diameter: — in. to — ft. and — in. to — ft.
 WELL WATER TO BE USED AS:
 1 Domestic — 3 Feedlot — 6 Oil field water supply — 9 Dewatering — 11 Injection well —
 2 Irrigation — 4 Industrial — 7 Lawn and garden only — 10 Monitoring well Plugged
 Was a chemical/bacteriological sample submitted to Department? Yes — No X; If yes, mo/day/yr sample was submitted —
 Water Well Disinfected? Yes — No X

5 TYPE OF BLANK CASING USED:
 1 Steel — 3 RMP (SR) — 5 Wrought iron — 8 Concrete tile — CASING JOINTS: Glued — Clamped —
PVC 4 ABS — 6 Asbestos-Cement — 9 Other (specify below) — Welded NA
 7 Fiberglass — Threaded NA
 Blank casing diameter: 2 in. to NA ft., Dia. NA in. to NA ft., Dia. NA in. to NA ft.
 Casing height above land surface: — in., weight — lbs./ft. Wall thickness or gauge No. —

TYPE OF SCREEN OR PERFORATION MATERIAL:
 1 Steel — 3 Stainless steel — 5 Fiberglass — 8 RMP (SR) — 10 Asbestos-cement —
 2 Brass — 4 Galvanized steel — 6 Concrete tile — 9 ABS — 11 Other (specify) —
 12 None used (open hole) —

SCREEN OR PERFORATION OPENINGS ARE:
 1 Continuous slot — 3 Mill slot — 5 Gauzed wrapped — 8 Saw cut — 11 None (open hole) —
 2 Louvered shutter — 4 Key punched — 6 Wire wrapped — 9 Drilled holes —
 7 Torch cut — 10 Other (specify) —

SCREEN-PERFORATED INTERVALS: From — ft. to — ft., From — ft. to — ft., From — ft. to — ft.
 GRAVEL PACK INTERVALS: From 12 ft. to 25 ft., From — ft. to — ft., From — ft. to — ft.

6 GROUT MATERIAL: 1 Neat cement — 2 Cement grout — 3 Bentonite 3 4 Other —
 Grout Intervals: From 3 ft. to 12 ft., From — ft. to — ft., From — ft. to — ft.

What is the nearest source of possible contamination:
 1 Septic tank — 4 Lateral lines — 7 Pit privy — 10 Livestock pens — 14 Abandoned water well —
 2 Sewer lines — 5 Cess pool — 8 Sewage lagoon — 11 Fuel storage — 15 Oil well/Gas well —
 3 Watertight sewer lines — 6 Seepage pit — 9 Feedyard — 12 Fertilizer storage — 16 Other (specify below) Former UST
 Direction from well? 20' south
 How many feet? —

FROM	TO	LITHOLOGIC LOG	FROM	TO	PLUGGING INTERVALS
0	3	Fill soil			
3	12	Bentonite plug			
12	25	Sand			
Casing was removed to 3' bgs.					

7 CONTRACTOR'S OR LANDOWNER'S CERTIFICATION: This water well was (1) constructed, (2) reconstructed, or (3) plugged under my jurisdiction and was completed on (mo/day/year) 7-25-95 and this record is true to the best of my knowledge and belief. Kansas Water Well Contractor's License No. 585 This Water Well Record was completed on (mo/day/yr) 8-25-95 under the business name of Assoc. Environ. Inc. by (signature) D Johnson for Dawn Duncan