


CMW-105

2211057

1 LOCATION OF WATER WELL: County: <u>Reno</u>	Fraction <u>NW 1/4 NE 1/4 NW 1/4</u>	Section Number <u>16</u>	Township Number T <u>23</u> S	Range Number R <u>5</u> EW
--	---	-----------------------------	----------------------------------	-------------------------------

Distance and direction from nearest town or city street address of well if located within city?
15 ft N of 2nd & W St. Kirby

2 WATER WELL OWNER: Groendyke Transport, Inc.
RR#, St. Address, Box #: 3015th Kirby
City, State, ZIP Code: Hutchinson, KS 67504
Board of Agriculture, Division of Water Resources
Application Number:

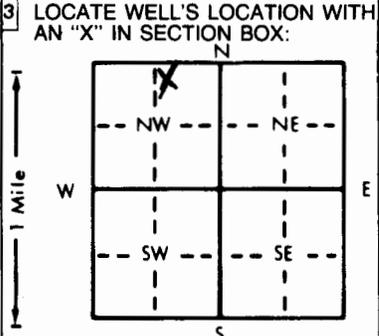

4 DEPTH OF COMPLETED WELL: 20.2 ft. ELEVATION:
Depth(s) Groundwater Encountered 1. 17.5 ft. 2. ft. 3. ft.
WELL'S STATIC WATER LEVEL: 13.18 ft. below land surface measured on mo/day/yr 4-15-96
Pump test data: Well water was ft. after hours pumping gpm
Est. Yield gpm: Well water was ft. after hours pumping gpm
Bore Hole Diameter: 8 in. to ft., and in. to ft.
WELL WATER TO BE USED AS:
5 Public water supply 8 Air conditioning 11 Injection well
1 Domestic 3 Feedlot 6 Oil field water supply 9 Dewatering 12 Other (Specify below)
2 Irrigation 4 Industrial 7 Lawn and garden only 10 Monitoring well
Was a chemical/bacteriological sample submitted to Department? Yes No X; If yes, mo/day/yr sample was submitted
Water Well Disinfected? Yes No X

5 TYPE OF BLANK CASING USED:
1 Steel 3 RMP (SR) 5 Wrought iron 8 Concrete tile CASING JOINTS: Glued Clamped
2 PVC 4 ABS 6 Asbestos-Cement 9 Other (specify below) Welded
7 Fiberglass Threaded Flush
Blank casing diameter: 2 in. to ft., Dia. in. to ft., Dia. in. to ft.
Casing height above land surface: Flush in., weight: 703 lbs./ft. Wall thickness or gauge No. Sch. 40
TYPE OF SCREEN OR PERFORATION MATERIAL:
1 Steel 3 Stainless steel 5 Fiberglass 7 PVC 10 Asbestos-cement
2 Brass 4 Galvanized steel 6 Concrete tile 8 RMP (SR) 11 Other (specify)
12 None used (open hole)
SCREEN OR PERFORATION OPENINGS ARE:
1 Continuous slot 3 Mill slot 5 Gauzed wrapped 8 Saw cut 11 None (open hole)
2 Louvered shutter 4 Key punched 6 Wire wrapped 9 Drilled holes
3 9.9 7 Torch cut 19.9 10 Other (specify)
SCREEN-PERFORATED INTERVALS: From ft. to ft., From ft. to ft.
GRAVEL PACK INTERVALS: From ft. to ft., From ft. to ft.

6 GROUT MATERIAL: 1 Neat cement 2 Cement grout 3 Bentonite 4 Other
Grout Intervals: From 3 ft. to 8 ft., From ft. to ft., From ft. to ft.
What is the nearest source of possible contamination:
1 Septic tank 4 Lateral lines 7 Pit privy 10 Livestock pens 14 Abandoned water well
2 Sewer lines 5 Cess pool 8 Sewage lagoon 11 Fuel storage 15 Oil well/Gas well
3 Watertight sewer lines 6 Seepage pit 9 Feedyard 12 Fertilizer storage 16 Other (specify below)
13 Insecticide storage

Direction from well? How many feet?

FROM	TO	LITHOLOGIC LOG	FROM	TO	PLUGGING INTERVALS
0	.4	silt			
.4	2	sand			
2	11.5	Clay			
11.5	20.2	sand			

Allison Irwin contacted Dan Taylor on 5-13-96 concerning Submittal of these late forms.

7 CONTRACTOR'S OR LANDOWNER'S CERTIFICATION: This water well was (1) constructed, (2) reconstructed, or (3) plugged under my jurisdiction and was completed on (mo/day/year) 4-15-96 and this record is true to the best of my knowledge and belief. Kansas Water Well Contractor's License No. 531 This Water Well Record was completed on (mo/day/yr) 6-10-96 under the business name of G&I by (signature) Allison Irwin