
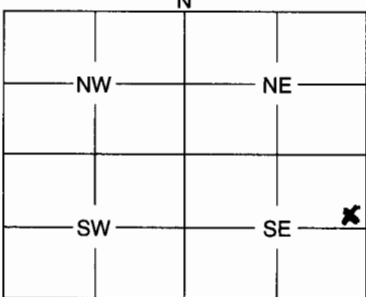


1	LOCATION OF WATER WELL:	Fraction	Section Number	Township Number	Range Number
County:	<u>ReNO</u>	<u>SE 1/4 NE 1/4 SE 1/4</u>	<u>18</u>	<u>23 S</u>	<u>5</u> 

Distance and direction from nearest town or city street address of well if located within city?

INTERSECTION OF S. LORRAINE AVE & CAREY BLVD. ON THE WEST SIDE OF LORRAINE

2	WATER WELL OWNER: <u>City of Hutchinson</u>	Board of Agriculture, Division of Water Resources
	RR #, St. Address, Box #: <u>P.O. Box 1567</u>	Application Number:
	City, State, ZIP Code: <u>Hutchinson, KS. 67504</u>	

3	MARK WELL'S LOCATION WITH AN "X" IN SECTION BOX:	4	DEPTH OF WELL <u>20</u> ft.												
			WELL'S STATIC WATER LEVEL <u>999</u> ft.												
			WELL WAS USED AS:												
			<table border="0"> <tr> <td>1 Domestic</td> <td>5 Public Water Supply</td> <td>9 Dewatering</td> </tr> <tr> <td>2 Irrigation</td> <td>6 Oil Field Water Supply</td> <td>10 Monitoring Well</td> </tr> <tr> <td>3 Feedlot</td> <td>7 Domestic (Lawn & Garden)</td> <td>11 Injection Well</td> </tr> <tr> <td>4 Industrial</td> <td>8 Air Conditioning</td> <td>12 Other</td> </tr> </table>	1 Domestic	5 Public Water Supply	9 Dewatering	2 Irrigation	6 Oil Field Water Supply	10 Monitoring Well	3 Feedlot	7 Domestic (Lawn & Garden)	11 Injection Well	4 Industrial	8 Air Conditioning	12 Other
1 Domestic	5 Public Water Supply	9 Dewatering													
2 Irrigation	6 Oil Field Water Supply	10 Monitoring Well													
3 Feedlot	7 Domestic (Lawn & Garden)	11 Injection Well													
4 Industrial	8 Air Conditioning	12 Other													
			Was a chemical / bacteriological sample submitted to Department? Yes No <u>X</u>												
			If yes, mo/day/yr sample was submitted												
			Water Well Disinfected: Yes No <u>X</u>												

5	TYPE OF BLANK CASING USED:										
	<table border="0"> <tr> <td>1 Steel</td> <td>3 RMP (SR)</td> <td>5 Wrought</td> <td>7 Fiberglass</td> <td>9 Other (Specify below)</td> </tr> <tr> <td>2 PVC</td> <td>4 ABS</td> <td>6 Asbestos-Cement</td> <td>8 Concrete Tile</td> <td></td> </tr> </table>	1 Steel	3 RMP (SR)	5 Wrought	7 Fiberglass	9 Other (Specify below)	2 PVC	4 ABS	6 Asbestos-Cement	8 Concrete Tile	
1 Steel	3 RMP (SR)	5 Wrought	7 Fiberglass	9 Other (Specify below)							
2 PVC	4 ABS	6 Asbestos-Cement	8 Concrete Tile								
	Blank casing diameter <u>2</u> in. Was casing pulled? Yes No <u>X</u> If yes, how much										
	Casing height above or below land surface <u>36</u> in.										

6	GROUT PLUG MATERIAL:	1 Neat cement	2 Cement grout	<u>3 Bentonite</u>	4 Other												
	Grout Plug Intervals:	From <u>20</u> ft.	to <u>3</u> ft.	From ft.	to ft.												
	What is the nearest source of possible contamination:																
	<table border="0"> <tr> <td>1 Septic tank</td> <td>6 Seepage pit</td> <td>11 Fuel storage</td> <td rowspan="5"><u>16 Other (specify below)</u> <u>open field</u> <u>north of old feed mill</u></td> </tr> <tr> <td>2 Sewer lines</td> <td>7 Pit privy</td> <td>12 Fertilizer storage</td> </tr> <tr> <td>3 Watertight sewer lines</td> <td>8 Sewage lagoon</td> <td>13 Insecticide storage</td> </tr> <tr> <td>4 Lateral lines</td> <td>9 Feedyard</td> <td>14 Abandoned water well</td> </tr> <tr> <td>5 Cess pool</td> <td>10 Livestock pens</td> <td>15 Oil well/Gas well</td> </tr> </table>	1 Septic tank	6 Seepage pit	11 Fuel storage	<u>16 Other (specify below)</u> <u>open field</u> <u>north of old feed mill</u>	2 Sewer lines	7 Pit privy	12 Fertilizer storage	3 Watertight sewer lines	8 Sewage lagoon	13 Insecticide storage	4 Lateral lines	9 Feedyard	14 Abandoned water well	5 Cess pool	10 Livestock pens	15 Oil well/Gas well
1 Septic tank	6 Seepage pit	11 Fuel storage	<u>16 Other (specify below)</u> <u>open field</u> <u>north of old feed mill</u>														
2 Sewer lines	7 Pit privy	12 Fertilizer storage															
3 Watertight sewer lines	8 Sewage lagoon	13 Insecticide storage															
4 Lateral lines	9 Feedyard	14 Abandoned water well															
5 Cess pool	10 Livestock pens	15 Oil well/Gas well															
	Direction from well? <u>999</u> How many feet? <u>999</u>																

FROM	TO	PLUGGING MATERIALS
<u>20'</u>	<u>3'</u>	<u>Volclay Grout Tremied</u>
		<u>From Bottom To 3ft</u>
		<u>Natural Clay Backfill</u>

NOTE: WELL # P5-3

RECEIVED

AUG 30 2004

BUREAU OF WATER

7	CONTRACTOR'S OF LANDOWNER'S CERTIFICATION: This water well was plugged under my jurisdiction and was completed on (mo/day/year) <u>8-5-04</u> and this record is true to the best of my knowledge and belief. Kansas Water Well Contractor's License No. <u>665</u> This Water Well Record was completed on (mo/day/year) <u>8-24-04</u> under the business name of <u>PRATT WELL ENVIRONMENTAL</u> by (signature) <u>[Signature]</u>
---	---

INSTRUCTIONS: Use typewriter or ball point pen. Please press firmly and print clearly. Please fill in blanks, underline or circle the correct answers. Send top three copies to Kansas Department of Health and Environment, Bureau of Water, Geology Section, 1000 SW Jackson St., Ste. 420, Topeka, Kansas 66612-1367. Telephone: 785/296-5522. Send one to Water Well Owner and retain one for your records.