


| | | | | | | | | | | |
|---------------------------|-------------|-----------|---------------|-----------|----------------|-----------------|---------------|--------------|---------------|----------------------|
| 1 LOCATION OF WATER WELL: | | Fraction | | | Section Number | Township Number | | Range Number | | |
| County: | Reno | SW | $\frac{1}{4}$ | SW | $\frac{1}{4}$ | SE | $\frac{1}{4}$ | 16 | T 23 S | R 05 W |

3300 E Avenue G

Application Number:

20 ft. ELEVATION:

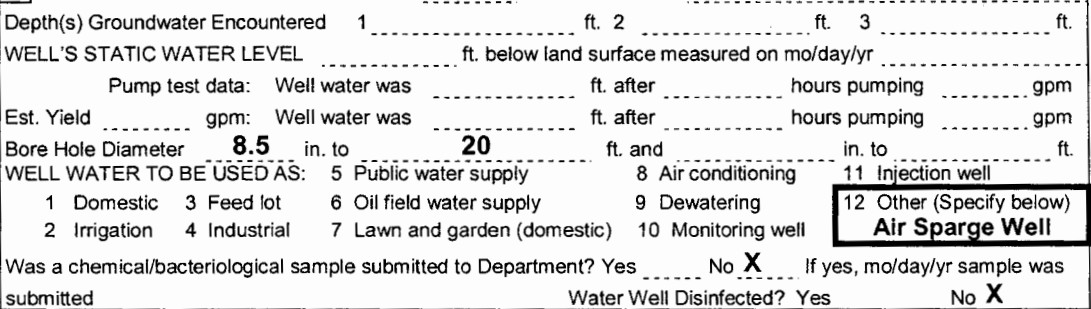

CASING JOINTS: Glued _____ Clamped _____

Welded

Threaded Flush

| | | | | | |
|----------------------------------|----|-------------|-------|--------------------------------------|--------|
| Casing height above land surface | 12 | in., weight | 0.703 | lbs./ft. Wall thickness or gauge No. | Sch 40 |
|----------------------------------|----|-------------|-------|--------------------------------------|--------|

| | |
|-------|--------------------|
| 7 PVC | 10 Asbestos-cement |
|-------|--------------------|

w cut 11 None (open hole)

9 Drilled holes

10 Other (specify)

GRAVEL PACK INTERVALS: From 17 ft. to 20 ft. From _____ ft. to _____ ft.

| | |
|-------------|--------------------------------|
| 3 Bentonite | 4 Other Bentonite Grout |
|-------------|--------------------------------|

| | | | | | | | | | | | | | |
|-----------------|------|----------|--------|-----------|----------|-----------|--------|-----------|----------|--|--------|--|-----|
| Grout Intervals | From | 2 | ft. to | 16 | ft. From | 16 | ft. to | 17 | ft. From | | ft. to | | ft. |
|-----------------|------|----------|--------|-----------|----------|-----------|--------|-----------|----------|--|--------|--|-----|

10 Livestock pens 14 Abandoned water well


| | | | | |
|--------------------------|-----------------|-----------------|------------------------|--------------------------|
| 1 Septic tank | 4 Lateral lines | 7 Pit privy | 11 Fuel storage | 15 Oil well/ Gas well |
| 2 Sewer lines | 5 Cess pool | 8 Sewage lagoon | 12 Fertilizer storage | 16 Other (specify below) |
| 3 Watertight sewer lines | 6 Seepage pit | 9 Feedyard | 13 Insecticide storage | |

Direction from well?

How many feet?

[illegible]

and this record is true to the best of my knowledge and belief. Kansas
This Water Well Record was completed on (mo/day/yr) 11-19-04

by (signature) 

INSTRUCTIONS: Please fill in blanks and circle the correct answers. Send three copies to Kansas Department of Health and Environment, Bureau of Water, 1000 S W Jackson St., Ste. 420, Topeka, Kansas 66612-1367. Telephone: 913-296-5545. Send one to WATER WELL OWNER and retain one for your records.