

CORRECTION(S) TO WATER WELL RECORD (WWC-5)
(to rectify lacking or incorrect information)

Location listed as:

Section-Township-Range: _____

Fraction ($\frac{1}{4}$ $\frac{1}{4}$ $\frac{1}{4}$): _____

County: _____

Location ~~changed to~~:

Reno
6-23-5W

NW NW SE

Other changes: Initial statements: _____

Changed to: _____

Comments: _____

owner name is Dennis May

well is located at owner's address: 25 Meadow-
lark

verification method: _____

call to driller

initials: DT

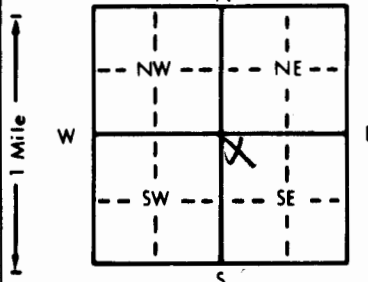
date: 7/21/05

submitted by: Kansas Geological Survey, Data Resources Library, 1930 Constant Ave., Lawrence, KS 66047-3726
to: Kansas Dept of Health & Environment, Bureau of Water, 1000 SW Jackson, Suite 420, Topeka, KS 66612-1367.

Distance and direction from nearest town or city street address of well if located within city?

2 WATER WELL OWNER: Dennis May
RR#, St. Address, Box #: 25 Meadowlark
City, State, ZIP Code: Dutchman KS-67502

Board of Agriculture, Division of Water Resources
Application Number:

3 LOCATE WELL'S LOCATION WITH AN "X" IN SECTION BOX:


4 DEPTH OF COMPLETED WELL: 30 ft. ELEVATION:
Depth(s) Groundwater Encountered 1. 15 ft. 2. 15 ft. 3. 15 ft.
WELL'S STATIC WATER LEVEL 15 ft. below land surface measured on mo/day/yr 9-7-04
Pump test data: Well water was _____ ft. after _____ hours pumping _____ gpm
Est. Yield _____ gpm: Well water was _____ ft. after _____ hours pumping _____ gpm
Bore Hole Diameter: 10 in. to 30 ft., and _____ in. to _____ ft.
WELL WATER TO BE USED AS: 5 Public water supply 8 Air conditioning 11 Injection well
1 Domestic 3 Feedlot 6 Oil field water supply 9 Dewatering 12 Other (Specify below)
2 Irrigation 4 Industrial 7 Lawn and garden only 10 Monitoring well _____
Was a chemical/bacteriological sample submitted to Department? Yes (No); If yes, mo/day/yr sample was submitted _____
Water Well Disinfected? Yes No

5 TYPE OF BLANK CASING USED:
1 Steel 3 RMP (SR) 5 Wrought iron 8 Concrete tile CASING JOINTS: Glued Clamped _____
2 PVC 4 ABS 6 Asbestos-Cement 9 Other (specify below) Welded _____
7 Fiberglass Threaded _____
Blank casing diameter 6 in. to 20 ft., Dia _____ in. to _____ ft., Dia _____ in. to _____ ft.
Casing height above land surface 14 in., weight 50R 26 lbs./ft. Wall thickness or gauge No. _____
TYPE OF SCREEN OR PERFORATION MATERIAL: PVC 10 Asbestos-cement
1 Steel 3 Stainless steel 5 Fiberglass 8 RMP (SR) 11 Other (specify) _____
2 Brass 4 Galvanized steel 6 Concrete tile 9 ABS 12 None used (open hole)
SCREEN OR PERFORATION OPENINGS ARE: 5 Gauzed wrapped 8 Saw cut 11 None (open hole)
1 Continuous slot 3 Mill slot 6 Wire wrapped 9 Drilled holes
2 Louvered shutter 4 Key punched 7 Torch cut 10 Other (specify) _____
SCREEN-PERFORATED INTERVALS: From 20 ft. to 30 ft., From _____ ft. to _____ ft.
GRAVEL PACK INTERVALS: From 20 ft. to 30 ft., From _____ ft. to _____ ft.

6 GROUT MATERIAL: 1 Neat cement 2 Cement grout 3 Bentonite 4 Other _____
Grout Intervals: From 0 ft. to 20 ft., From _____ ft. to _____ ft., From _____ ft. to _____ ft.
What is the nearest source of possible contamination:
1 Septic tank 4 Lateral lines 7 Pit privy 10 Livestock pens 14 Abandoned water well
2 Sewer lines 5 Cess pool 8 Sewage lagoon 11 Fuel storage 15 Oil well/Gas well
3 Watertight sewer lines 6 Seepage pit 9 Feedyard 12 Fertilizer storage 16 Other (specify below)
13 Insecticide storage
Direction from well? N How many feet? 60

FROM		TO		LITHOLOGIC LOG	FROM	TO	PLUGGING INTERVALS
0	3	3	12	Top Soil			
3	12	12	15	Clay			
12	15	15	30	Sand Fin			
15	30			Sand Course			

7 CONTRACTOR'S OR LANDOWNER'S CERTIFICATION: This water well was (1) constructed, (2) reconstructed, or (3) plugged under my jurisdiction and was completed on (mo/day/year) 9-7-04 and this record is true to the best of my knowledge and belief. Kansas Water Well Contractor's License No. 440 This Water Well Record was completed on (mo/day/yr) 9-15-04
under the business name of Carl Vincent Sen by (signature) [Signature]