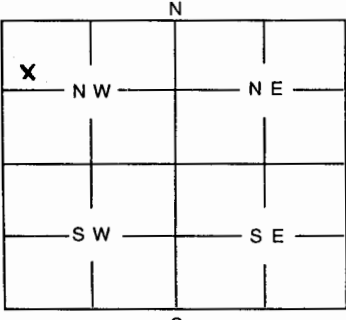


1	LOCATION OF WATER WELL: County: <u>Reno</u>	Fraction <u>SW 1/4 NW 1/4 NW 1/4</u>	Section Number <u>8</u>	Township Number <u>23</u>	Range Number <u>5W</u>																											
Distance and direction from nearest town or city street address of well if located within city? <u>1400 N. Lorraine, Hutchinson, Ks.</u>																																
2	WATER WELL OWNER: <u>HPA Associates, LLC</u> RR #, St. Address, Box #: <u>210 Regency Parkway</u> City, State, ZIP Code: <u>Omaha, NE 68114</u> Board of Agriculture, Division of Water Resources Application Number: <u>45,537</u>																															
3	MARK WELL'S LOCATION WITH AN "X" IN SECTION BOX: <div style="text-align: center;">  </div>	4	DEPTH OF WELL <u>40</u> ft. WELL'S STATIC WATER LEVEL <u>13</u> ft. WELL WAS USED AS: <table style="width:100%;"> <tr> <td>1 Domestic</td> <td>5 Public Water Supply</td> <td>9 Dewatering</td> </tr> <tr> <td>2 Irrigation</td> <td>6 Oil Field Water Supply</td> <td>10 Monitoring Well</td> </tr> <tr> <td>3 Feedlot</td> <td>7 Domestic (Lawn & Garden)</td> <td>11 Injection Well</td> </tr> <tr> <td>4 Industrial</td> <td>8 Air Conditioning</td> <td>12 <u>Other supply-cooling use</u></td> </tr> </table> Was a chemical / bacteriological sample submitted to Department? Yes No <u>X</u> If yes, mo/day/yr sample was submitted Water Well Disinfected: Yes <u>X</u> No			1 Domestic	5 Public Water Supply	9 Dewatering	2 Irrigation	6 Oil Field Water Supply	10 Monitoring Well	3 Feedlot	7 Domestic (Lawn & Garden)	11 Injection Well	4 Industrial	8 Air Conditioning	12 <u>Other supply-cooling use</u>															
1 Domestic	5 Public Water Supply	9 Dewatering																														
2 Irrigation	6 Oil Field Water Supply	10 Monitoring Well																														
3 Feedlot	7 Domestic (Lawn & Garden)	11 Injection Well																														
4 Industrial	8 Air Conditioning	12 <u>Other supply-cooling use</u>																														
5	TYPE OF BLANK CASING USED: 1 Steel 3 RMP (SR) 5 Wrought 7 Fiberglass 9 Other (Specify below) 2 <u>PVC</u> 4 ABS 6 Asbestos-Cement 8 Concrete Tile Blank casing diameter <u>6</u> in. Was casing pulled? Yes No <u>X</u> If yes, how much Casing height above or <u>below</u> land surface <u>36</u> in.																															
6	GROUT PLUG MATERIAL: 1 Neat cement 2 Cement grout 3 Bentonite 4 <u>Other</u> <u>Hole Plug - Sand - Dirt</u> Grout Plug Intervals: From <u>40</u> ft. to <u>15</u> ft., From <u>15</u> ft. to <u>4</u> ft., From <u>4</u> ft. to <u>0</u> ft. What is the nearest source of possible contamination: <table style="width:100%;"> <tr> <td>1 Septic tank</td> <td>6 Seepage pit</td> <td>11 Fuel storage</td> <td>16 <u>Other (specify below)</u></td> </tr> <tr> <td>2 Sewer lines</td> <td>7 Pit privy</td> <td>12 Fertilizer storage</td> <td><u>Supply well - cooling use</u></td> </tr> <tr> <td>3 Watertight sewer lines</td> <td>8 Sewage lagoon</td> <td>13 Insecticide storage</td> <td></td> </tr> <tr> <td>4 Lateral lines</td> <td>9 Feedyard</td> <td>14 Abandoned water well</td> <td></td> </tr> <tr> <td>5 Cess Pool</td> <td>10 Livestock pens</td> <td>15 Oil well/Gas well</td> <td></td> </tr> </table> Direction from well? <u>W</u> How many feet? <u>15</u>					1 Septic tank	6 Seepage pit	11 Fuel storage	16 <u>Other (specify below)</u>	2 Sewer lines	7 Pit privy	12 Fertilizer storage	<u>Supply well - cooling use</u>	3 Watertight sewer lines	8 Sewage lagoon	13 Insecticide storage		4 Lateral lines	9 Feedyard	14 Abandoned water well		5 Cess Pool	10 Livestock pens	15 Oil well/Gas well								
1 Septic tank	6 Seepage pit	11 Fuel storage	16 <u>Other (specify below)</u>																													
2 Sewer lines	7 Pit privy	12 Fertilizer storage	<u>Supply well - cooling use</u>																													
3 Watertight sewer lines	8 Sewage lagoon	13 Insecticide storage																														
4 Lateral lines	9 Feedyard	14 Abandoned water well																														
5 Cess Pool	10 Livestock pens	15 Oil well/Gas well																														
<table border="1" style="width:100%; border-collapse: collapse;"> <thead> <tr> <th style="width:15%;">FROM</th> <th style="width:15%;">TO</th> <th style="width:70%;">PLUGGING MATERIALS</th> </tr> </thead> <tbody> <tr> <td><u>0</u></td> <td><u>4</u></td> <td><u>Dirt</u></td> </tr> <tr> <td><u>4</u></td> <td><u>15</u></td> <td><u>Hole Plug</u></td> </tr> <tr> <td><u>15</u></td> <td><u>40</u></td> <td><u>Sand</u></td> </tr> <tr><td> </td><td> </td><td> </td></tr> <tr><td> </td><td> </td><td> </td></tr> <tr><td> </td><td> </td><td> </td></tr> <tr><td> </td><td> </td><td> </td></tr> <tr><td> </td><td> </td><td> </td></tr> </tbody> </table>						FROM	TO	PLUGGING MATERIALS	<u>0</u>	<u>4</u>	<u>Dirt</u>	<u>4</u>	<u>15</u>	<u>Hole Plug</u>	<u>15</u>	<u>40</u>	<u>Sand</u>															
FROM	TO	PLUGGING MATERIALS																														
<u>0</u>	<u>4</u>	<u>Dirt</u>																														
<u>4</u>	<u>15</u>	<u>Hole Plug</u>																														
<u>15</u>	<u>40</u>	<u>Sand</u>																														
7	CONTRACTOR'S OR LANDOWNER'S CERTIFICATION: This water well was plugged under my jurisdiction and was completed on (mo/day/year) <u>7-6-05</u> and this record is true to the best of my knowledge and belief. Kansas Water Well Contractor's License No. <u>134</u> This Water Well Record was completed on (mo/day/year) <u>7-8-05</u> under the business name of <u>Rosemeadow - Bemis Ent.</u> by (signature) <u>Jessie Doherty</u>																															

INSTRUCTIONS: Use typewriter or ball point pen. Please press firmly and print clearly. Please fill in blanks, underline or circle the correct answers. Send top three copies to Kansas Department of Health and Environment, Bureau of Water, Topeka, Kansas 66620-0001. Telephone: 785/296-3565. Send one to Water Well Owner and retain one for your records.