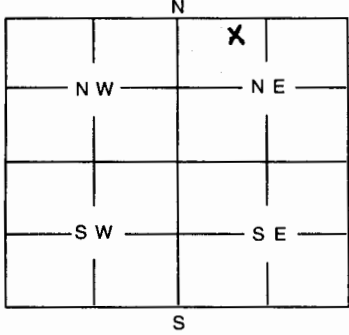


| | | | | | |
|---|--|---|----------------------------|------------------------------|--------------------------|
| 1 | LOCATION OF WATER WELL: County: Reno | Fraction NE 1/4 NW 1/4 NE 1/4 | Section Number 5 | Township Number 23 | Range Number 5 |
|---|--|---|----------------------------|------------------------------|--------------------------|

Distance and direction from nearest town or city street address of well if located within city?

| | | |
|---|--|--|
| 2 | WATER WELL OWNER: Kristina Griffith RR #, St. Address, Box #: 2806 Malloy City, State, ZIP Code: Hutchinson, Ks | Board of Agriculture, Division of Water Resources Application Number: |
|---|--|--|

| | | | |
|---|--|---|--|
| 3 | MARK WELL'S LOCATION WITH AN "X" IN SECTION BOX:  | 4 | DEPTH OF WELL 25 ft WELL'S STATIC WATER LEVEL 10 ft. WELL WAS USED AS: 1 Domestic 2 Irrigation 3 Feedlot 4 Industrial 5 Public Water Supply 6 Oil Field Water Supply 7 <u>Domestic (Lawn & Garden)</u> 8 Air Conditioning 9 Dewatering 10 Monitoring Well 11 Injection Well 12 Other Was a chemical / bacteriological sample submitted to Department? Yes No X If yes, mo/day/yr sample was submitted Water Well Disinfected: Yes X No |
|---|--|---|--|

| | |
|---|---|
| 5 | TYPE OF BLANK CASING USED: 1 Steel 2 PVC 3 RMP (SR) 4 ABS 5 Wrought 6 Asbestos-Cement 7 Fiberglass 8 Concrete Tile 9 Other (Specify below) TIN Blank casing diameter 5 in. Was casing pulled? Yes No X If yes, how much Casing height above or below land surface 60 in. |
|---|---|

| | |
|---|--|
| 6 | GROUT PLUG MATERIAL: 1 Neat cement 2 Cement grout 3 Bentonite 4 Other Hole Plug Grout Plug Intervals: From 5 ft. to 25 ft., From ft. to ft., From ft. to ft. What is the nearest source of possible contamination: 1 Septic tank 2 Sewer lines 3 Watertight sewer lines 4 Lateral lines 5 Cess Pool 6 Seepage pit 7 Pit privy 8 Sewage lagoon 9 Feedyard 10 Livestock pens 11 Fuel storage 12 Fertilizer storage 13 Insecticide storage 14 Abandoned water well 15 Oil well/Gas well 16 Other (specify below) NONE Direction from well? How many feet? |
|---|--|

| FROM | TO | PLUGGING MATERIALS |
|----------|-----------|--------------------|
| 0 | 5 | Dirt |
| 5 | 25 | Hole Plug |
| | | |
| | | |
| | | |
| | | |
| | | |

| | |
|---|---|
| 7 | CONTRACTOR'S OR LANDOWNER'S CERTIFICATION: This water well was plugged under my jurisdiction and was completed on (mo/day/year) 9-14-05 and this record is true to the best of my knowledge and belief. Kansas Water Well Contractor's License No. 134 This Water Well Record was completed on (mo/day/year) 9-16-05 under the business name of Rosecrans Berry Ent. by (signature) Jessie Dodson |
|---|---|

INSTRUCTIONS: Use typewriter or ball point pen. Please press firmly and print clearly. Please fill in blanks, underline or circle the correct answers. Send top three copies to Kansas Department of Health and Environment, Bureau of Water, Topeka, Kansas 66620-0001. Telephone: 785/296-3565. Send one to Water Well Owner and retain one for your records.