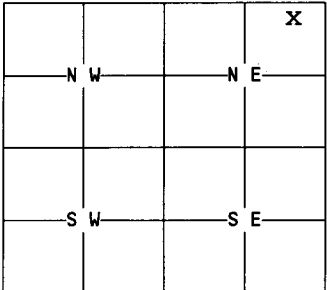


1	LOCATION OF WATER WELL: County: RENO	Fraction 1/4 NE 1/4 NE 1/4	Section Number 6	Township Number 23	Range Number 5-W
---	---	-------------------------------	---------------------	-----------------------	---------------------

Distance and direction from nearest town or city street address of well if located within city?  
1215 EAST 30th ST HUTCHINSON, KS

2	WATER WELL OWNER: u-DO-IT KDHE U2-078-179
RR#, St. Address, Box #: HUTCHINSON KS Board of Agriculture, Division of Water Resources	
City, State, ZIP Code : 1215 EAST 30th ST Application Number:	

3	MARK WELL'S LOCATION WITH AN "X" IN SECTION BOX: N  S	4	DEPTH OF WELL.....28.5.....ft. WELL'S STATIC WATER LEVEL.....17.....ft. WELL WAS USED AS: 1 Domestic 5 Public Water Supply 9 Dewatering 2 Irrigation 6 Oil Field Water Supply 10 Monitoring Well 3 Feedlot 7 Lawn and Garden Only 11 Injection Well 4 Industrial 8 Air Conditioning 12 Other..... Was a chemical/bacteriological sample submitted to Department? Yes. <input checked="" type="checkbox"/> No..... If yes, mo/day/yr sample was submitted..... Water Well Disinfected: Yes..... No.....
---	---	---	---

5	TYPE OF BLANK CASING USED: 1 Steel 3 RMP (SR) 5 Wrought 7 Fiberglass 9 Other (specify below) 2 PVC 4 ABS 6 Asbestos-Cement 8 Concrete Tile ..... Blank casing diameter.....2.....in. Was casing pulled? Yes. <input checked="" type="checkbox"/> No..... If yes, how much.....13.5..... Casing height above or below land surface.....-3.....in.
---	--

6	<p>GROUT PLUG MATERIAL: <input checked="" type="checkbox"/> Neat cement 2 Cement grout 3 Bentonite 4 Other.....</p> <p>Grout Plug Intervals: From.....28.5.....ft. to.....0.....ft., From.....ft. to.....ft., From..... to.....ft.</p> <p>What is the nearest source of possible contamination:</p> <table> <tr> <td>1 Septic tank</td> <td>6 Seepage pit</td> <td>11 Fuel storage</td> <td>16 Other (specify below)</td> </tr> <tr> <td>2 Sewer lines</td> <td>7 Pit privy</td> <td>12 Fertilizer storage</td> <td></td> </tr> <tr> <td><input checked="" type="checkbox"/> Watertight sewer lines</td> <td>8 Sewage lagoon</td> <td>13 Insecticide storage</td> <td></td> </tr> <tr> <td>4 Lateral lines</td> <td>9 Feedyard</td> <td>14 Abandoned water well</td> <td></td> </tr> <tr> <td>5 Cess Pool</td> <td>10 Livestock pens</td> <td>15 Oil well/Gas well</td> <td></td> </tr> </table> <p>NORTH 15</p> <p>Direction from well? ..... How many feet? .....</p>	1 Septic tank	6 Seepage pit	11 Fuel storage	16 Other (specify below)	2 Sewer lines	7 Pit privy	12 Fertilizer storage		<input checked="" type="checkbox"/> Watertight sewer lines	8 Sewage lagoon	13 Insecticide storage		4 Lateral lines	9 Feedyard	14 Abandoned water well		5 Cess Pool	10 Livestock pens	15 Oil well/Gas well	
1 Septic tank	6 Seepage pit	11 Fuel storage	16 Other (specify below)																		
2 Sewer lines	7 Pit privy	12 Fertilizer storage																			
<input checked="" type="checkbox"/> Watertight sewer lines	8 Sewage lagoon	13 Insecticide storage																			
4 Lateral lines	9 Feedyard	14 Abandoned water well																			
5 Cess Pool	10 Livestock pens	15 Oil well/Gas well																			

FROM	TO	PLUGGING MATERIALS
28.5	0	NEAT CEMENT W/6% BENTONITE
		PULLED SCREEN & CASING
		IMPLACED VIA TREMIE

7	<p>CONTRACTOR'S OR LANDOWNER'S CERTIFICATION: This water well was plugged under my jurisdiction and was completed on (mo/day/year).....10-2-98..... and this record is true to the best of my knowledge and belief. Kansas Water Well Contractor's License No. ....575..... This Water Well Record was completed on (mo/day/year).....10-26-98..... under the business name of .....KURTZ ENVIRONMENTAL SERVICE..... by (signature) .....</p>
---	---

INSTRUCTIONS: Use typewriter or ball point pen. Please press firmly and print clearly. Please fill in blanks, underline or circle the correct answers. Send top three copies to Kansas Department of Health and Environment, Bureau of Water, Topeka, Kansas 66620-0001. Telephone: 913/296-3565. Send one to Water Well Owner and retain one for your records.