

1 LOCATION OF WATER WELL:	Fraction	Section Number	Township Number	Range Number
County: <u>RENO</u>	<u>SW 1/4 SW 1/4 SW 1/4</u>	<u>6</u>	<u>T 23 S</u>	<u>R 5 E</u>

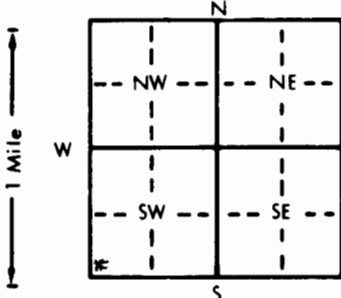
Distance and direction from nearest town or city street address of well if located within city?

From SW CORNER OF SEC. 6 47N, 54E

2 WATER WELL OWNER: <u>OWENS OIL COMPANY</u>	<u>MW-6</u>	Board of Agriculture, Division of Water Resources
RR#, St. Address, Box #: <u>434 EAST 17th ST.</u>		
City, State, ZIP Code: <u>HUTCHINSON, KS 67501</u>		

Application Number:

3 LOCATE WELL'S LOCATION WITH AN "X" IN SECTION BOX:	4 DEPTH OF COMPLETED WELL: <u>24</u> ft. ELEVATION: <u>706 1533.86</u>
--	--


WELL WATER TO BE USED AS: 5 Public water supply 8 Air conditioning 11 Injection well

1 Domestic 3 Feedlot 6 Oil field water supply 9 Dewatering 12 Other (Specify below)

2 Irrigation 4 Industrial 7 Lawn and garden only 10 Monitoring wellWas a chemical/bacteriological sample submitted to Department? Yes No If yes, mo/day/yr sample was submittedWater Well Disinfected? Yes No

5 TYPE OF BLANK CASING USED:	5 Wrought iron	8 Concrete tile	CASING JOINTS: Glued <u>Clamped</u>
1 Steel	3 RMP (SR)	6 Asbestos-Cement	9 Other (specify below)
<u>3</u> PVC	4 ABS	7 Fiberglass	Welded
Blank casing diameter <u>2</u> in. to <u>2</u> ft., Dia			Threaded


TYPE OF SCREEN OR PERFORATION MATERIAL:

1 Steel	3 Stainless steel	5 Fiberglass	8 RMP (SR)	11 Other (specify)
2 Brass	4 Galvanized steel	6 Concrete tile	9 ABS	12 None used (open hole)

SCREEN OR PERFORATION OPENINGS ARE:

1 Continuous slot	<u>3</u> Mill slot	5 Gauzed wrapped	8 Saw cut	11 None (open hole)
2 Louvered shutter	4 Key punched	6 Wire wrapped	9 Drilled holes	
		7 Torch cut	10 Other (specify)	


6 GROUT MATERIAL:	1 Neat cement	<u>2</u> Cement grout	3 Bentonite	4 Other
Grout Intervals: From <u>7</u> ft. to <u>9</u> ft., From <u>9</u> ft. to <u>24</u> ft., From <u>9</u> ft. to <u>24</u> ft.				

What is the nearest source of possible contamination:

1 Septic tank	4 Lateral lines	7 Pit privy	<u>11</u> Fuel storage	14 Abandoned water well
2 Sewer lines	5 Cess pool	8 Sewage lagoon	12 Fertilizer storage	15 Oil well/Gas well
3 Watertight sewer lines	6 Seepage pit	9 Feedyard	13 Insecticide storage	16 Other (specify below)

Direction from well?

How many feet?

FROM	TO	LITHOLOGIC LOG	FROM	TO	PLUGGING INTERVALS
<u>0</u>	<u>5'</u>	<u>SILT, BROWN, MOIST, TITK, FINE-TO-MED</u>			
<u>5'</u>	<u>10'</u>	<u>SAND, TAN, VERY FINE GRAINED, STAINY, FINE-TO-MED</u>			
<u>10'</u>	<u>15'</u>	<u>SAND, TAN-GRAY, MED. COARSE, GRAIN, UNCONSOLIDATED</u>			
<u>15'</u>	<u>24'</u>	<u>SAND, TAN, COARSE, GRAIN, UNCONSOLIDATED, F.O.</u>			

7 CONTRACTOR'S OR LANDOWNER'S CERTIFICATION: This water well was <u>(1)</u> constructed, (2) reconstructed, or (3) plugged under my jurisdiction and was completed on (mo/day/year) <u>3/5/98</u> and this record is true to the best of my knowledge and belief. Kansas Water Well Contractor's License No. <u>483</u> This Water Well Record was completed on (mo/day/yr) <u>4/30/98</u> under the business name of <u>OWENS OIL COMPANY</u> by (signature) <u>[Signature]</u>
--

INSTRUCTIONS: Use typewriter or ball point pen. PLEASE PRESS FIRMLY and PRINT clearly. Please fill in blanks, underline or circle the correct answers. Send top three copies to Kansas Department of Health and Environment, Bureau of Water, Topeka, Kansas 66620-0001. Telephone: 913-296-5545. Send one to WATER WELL OWNER and retain one for your records.