


Corrected

WATER WELL RECORD Form WWC-5 KSA 82a-1212

1 LOCATION OF WATER WELL: County: Reno Fraction SW 1/4 NW 1/4 SW 1/4 Section Number 4 Township Number T 23 S Range Number R 5 EW

Distance and direction from nearest town or city street address of well if located within city? 1700 N. Halstead Road, Hutchinson

2 WATER WELL OWNER: ADM RR#, St. Address, Box #: 4666 Fairies Parkway Board of Agriculture, Division of Water Resources City, State, ZIP Code: Decatur, IL 62521 Application Number:

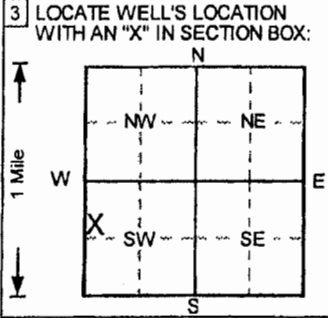

4 DEPTH OF COMPLETED WELL: 25 ft. ELEVATION: ... WELL'S STATIC WATER LEVEL: 10.25 ft. below land surface measured on 4/4/2006. Pump test data: Well water was NA ft. after ... hours pumping ... gpm. Est. Yield NA gpm. Well water was ... ft. after ... hours pumping ... gpm. Bore Hole Diameter 8 in. to 27 ft. and ... in. to ... ft. WELL WATER TO BE USED AS: 5 Public water supply 8 Air conditioning 11 Injection well 1 Domestic 3 Feedlot 6 Oil field water supply 9 Dewatering 12 Other (Specify below) 2 Irrigation 4 Industrial 7 Lawn and garden only 10 Monitoring well. Was a chemical/bacteriological sample submitted to Department? Yes No. If yes, mo/day/yr sample was submitted. Water Well Disinfected? Yes No.

5 TYPE OF BLANK CASING USED: 1 Steel 2 PVC 3 RMP (SR) 4 ABS 5 Wrought iron 6 Asbestos-Cement 7 Fiberglass 8 Concrete tile 9 Other (specify below) CASING JOINTS: Glued Clamped Welded Threaded. Blank casing diameter 2 in. to 15 ft. Dia. in. to ... ft. Dia. in. to ... ft. Casing height above land surface 0 in., weight ... lbs./ft. Wall thickness or gauge No. Sch. 40. TYPE OF SCREEN OR PERFORATION MATERIAL: 1 Steel 2 Brass 3 Stainless steel 4 Galvanized steel 5 Fiberglass 6 Concrete tile 7 PVC 8 RMP (SR) 9 ABS 10 Asbestos-cement 11 Other (specify) 12 None used (open hole). SCREEN OR PERFORATION OPENINGS ARE: 1 Continuous slot 2 Louvered shutter 3 Mill slot 4 Key punched 5 Gauzed wrapped 6 Wire wrapped 7 Torch cut 8 Saw cut 9 Drilled holes 10 Other (specify) 11 None (open hole). SCREEN-PERFORATED INTERVALS: From 15 ft. to 25 ft. From ... ft. to ... ft. GRAVEL PACK INTERVALS: From 13 ft. to 25 ft. From 25 ft. to 27 ft. From ... ft. to ... ft. From ... ft. to ... ft.

6 GROUT MATERIAL: 1 Neat cement 2 Cement grout 3 Bentonite 4 Other Concrete. Grout Intervals: From 0 ft. to 1 ft. From 1 ft. to 1 ft. From ... ft. to ... ft. What is the nearest source of possible contamination: 1 Septic tank 2 Sewer lines 3 Watertight sewer lines 4 Lateral lines 5 Cess pool 6 Seepage pit 7 Pit privy 8 Sewage lagoon 9 Feedyard 10 Livestock pens 11 Fuel storage 12 Fertilizer storage 13 Insecticide storage 14 Abandoned water well 15 Oil well/Gas well 16 Other (specify below). Direction from well?

Table with columns: FROM, TO, LITHOLOGIC LOG, FROM, TO, PLUGGING INTERVALS. Rows: 0-1 Topsoil, organic, rich, sandy, silty; 1-3 Silt, moist, Dark Brown; 3-6 Sand, silty, dry to moist, Orange; 6-10 Sand (f-m), loose, dry to moist, Pinkish Orange; 10-27 Sand (f-c), multicolored washed sand, Overall. Bottom row: MW2, Flushmount; Project Name: Huff Huff - ADM Hutch; GeoCore # 1285, #

7 CONTRACTOR'S OR LANDOWNER'S CERTIFICATION: This water well was (1) constructed, (2) reconstructed, or (3) plugged under my jurisdiction and was completed on (mo/day/year) 5/31/2006 and this record is true to the best of my knowledge and belief. Kansas Water Well Contractor's License No. 527 This Water Well Record was completed on (mo/day/yr) 5/31/2006 under the business name of GeoCore, Inc. by (signature) Dale Huff

INSTRUCTIONS: Use typewriter or ball point pen. PLEASE PRESS FIRMLY and PRINT clearly. Please fill in blanks, underline or circle the correct answers. Send top three copies to Kansas Department of Health and Environment, Bureau of Water, Topeka, Kansas 66620-0001. Telephone: 913-296-5545. Send one to WATER WELL OWNER and retain one for your records.

OFFICE USE ONLY T R EM SEC