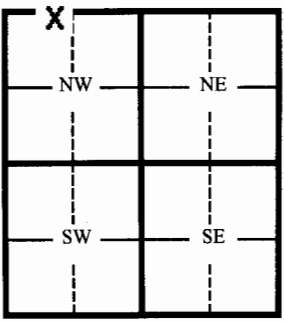


1 LOCATION OF WATER WELL:	Fraction	Section Number	Township Number	Range Number
County: Reno	NE ¼ NW ¼ NW ¼	8	23	5-West

Distance and direction from nearest town or city street address of well if located within city?
1525 E. 17th Avenue, Hutchinson, Kansas

2 WATER WELL OWNER: Kwik Shop, Inc. RR#, St. Address, Box # 734 E. 4th Avenue City, State, ZIP Code : Hutchinson, Kansas 67504	Board of Agriculture, Division of Water Resources Application Number:
--	--

3 MARK WELL'S LOCATION WITH AN "X" IN SECTION BOX:


4 DEPTH OF WELL 25.0 ft.
 WELL'S STATIC WATER LEVEL 13.22 ft.
 WELL WAS USED AS:

1 Domestic
 2 Irrigation
 3 Feedlot
 4 Industrial

5 Public Water Supply
 6 Oil Field Water Supply
 7 Lawn and Garden (domestic)
 8 Air Conditioning

9 Dewatering
 10 Monitoring Well
 11 Injection Well
 12 Other

 Was a chemical/bacteriological sample submitted to Department? Yes ___ No X
 If yes, mo/day/yr sample was submitted _____
 Water Well Disinfected: Yes ___ No X

5 TYPE OF BLANK CASING USED:
 1 Steel 3 RMP (SR) 5 Wrought 7 Fiberglass 9 Other (specify below)
 2 PVC 4 ABC 6 Asbestos-Cement 8 Concrete Tile
 Blank casing diameter 2.375 in. Was casing pulled? Yes X No ___ If yes, how much? 25'
 Casing height above or below land surface Unknown in. **Overdrilled well to 20'**

6 GROUT PLUG MATERIAL: 1 Neat cement 2 Cement grout 3 Bentonite 4 Other Soils/Concrete
 Grout Plug Intervals From 25.0 ft. to 3.0 ft. From 3.0 ft. to 1.0 ft. From 1.0 ft. to 0.0 ft.
 What is the nearest source of possible contamination:

1 Septic tank
 2 Sewer lines
 3 Watertight sewer lines
 4 Lateral lines
 5 Cess Pool


6 Seepage pit
 7 Pit privy
 8 Sewage lagoon
 9 Feedyard
 10 Livestock pens

11 Fuel storage (former)
 12 Fertilizer storage
 13 Insecticide storage
 14 Abandoned water well
 15 Oil well/ Gas well

16 Other (specify below)

 Direction from well? East How many feet? 5

FROM	TO	CODE	PLUGGING MATERIALS
0.0	1.0		Concrete
1.0	3.0		Soils
3.0	25.0		Bentonite chips

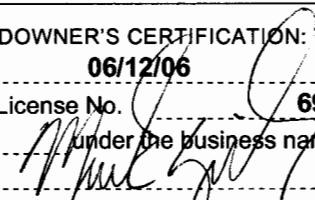7 CONTRACTOR'S OR LANDOWNER'S CERTIFICATION: This water well was plugged under my jurisdiction and was completed on (mo/day/yr) 06/12/06 and this record is true to the best of my knowledge and belief. Kansas Water Well Contractor's License No. 692 This Water Well Record was completed on (mo/day/yr) 06/18/06 under the business name of Quad State Services, Inc.
 by (signature) 

INSTRUCTIONS: Please fill in blanks and circle the correct answers. Send three copies to Kansas Department of Health and Environment, Bureau of Water, 1000 S W Jackson St., Ste. 420, Topeka, Kansas 66620-0001. Telephone: 785-296-3565. Send one to Water Well Owner and retain one for your records.