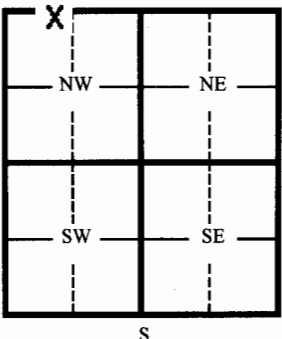
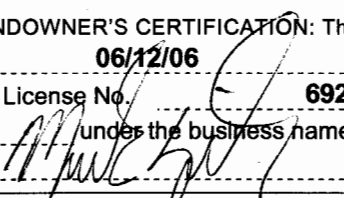


1 LOCATION OF WATER WELL:	Fraction	Section Number	Township Number	Range Number																																
County: Reno	NE 1/4 NW 1/4 NW 1/4	8	23	5-West																																
Distance and direction from nearest town or city street address of well if located within city? 1525 E. 17th Avenue, Hutchinson, Kansas																																				
2 WATER WELL OWNER: Kwik Shop, Inc.																																				
RR#, St. Address, Box # 734 E. 4th Avenue		Board of Agriculture, Division of Water Resources																																		
City, State, ZIP Code : Hutchinson, Kansas 67504		Application Number:																																		
3 MARK WELL'S LOCATION WITH AN "X" IN SECTION BOX: <div style="text-align: center; margin-top: 10px;"></div>		4 DEPTH OF WELL <u>20.0</u> ft. WELL'S STATIC WATER LEVEL <u>15.19</u> ft. WELL WAS USED AS: <table style="width:100%;"><tr><td>1 Domestic</td><td>5 Public Water Supply</td><td>9 Dewatering</td></tr><tr><td>2 Irrigation</td><td>6 Oil Field Water Supply</td><td>10 Monitoring Well</td></tr><tr><td>3 Feedlot</td><td>7 Lawn and Garden (domestic)</td><td>11 Injection Well</td></tr><tr><td>4 Industrial</td><td>8 Air Conditioning</td><td>12 Other</td></tr></table> Was a chemical/bacteriological sample submitted to Department? Yes _____ No <u>X</u> If yes, mo/day/yr sample was submitted _____ Water Well Disinfected: Yes _____ No <u>X</u>			1 Domestic	5 Public Water Supply	9 Dewatering	2 Irrigation	6 Oil Field Water Supply	10 Monitoring Well	3 Feedlot	7 Lawn and Garden (domestic)	11 Injection Well	4 Industrial	8 Air Conditioning	12 Other																				
1 Domestic	5 Public Water Supply	9 Dewatering																																		
2 Irrigation	6 Oil Field Water Supply	10 Monitoring Well																																		
3 Feedlot	7 Lawn and Garden (domestic)	11 Injection Well																																		
4 Industrial	8 Air Conditioning	12 Other																																		
5 TYPE OF BLANK CASING USED: <table style="width:100%;"><tr><td>1 Steel</td><td>3 RMP (SR)</td><td>5 Wrought</td><td>7 Fiberglass</td><td>9 Other (specify below)</td></tr><tr><td>2 PVC</td><td>4 ABC</td><td>6 Asbestos-Cement</td><td>8 Concrete Tile</td><td></td></tr></table> Blank casing diameter <u>2.375</u> in. Was casing pulled? Yes <u>X</u> No _____ If yes, how much? <u>20'</u> Casing height above or below land surface <u>Unknown</u> in. Overdrilled well to 20'					1 Steel	3 RMP (SR)	5 Wrought	7 Fiberglass	9 Other (specify below)	2 PVC	4 ABC	6 Asbestos-Cement	8 Concrete Tile																							
1 Steel	3 RMP (SR)	5 Wrought	7 Fiberglass	9 Other (specify below)																																
2 PVC	4 ABC	6 Asbestos-Cement	8 Concrete Tile																																	
6 GROUT PLUG MATERIAL: 1 Neat cement 2 Cement grout <u>3</u> Bentonite <u>4</u> Other Soils Grout Plug Intervals From <u>20.0</u> ft. to <u>3.0</u> ft. From <u>3.0</u> ft. to <u>0.0</u> ft. From _____ ft. to _____ ft. What is the nearest source of possible contamination: <table style="width:100%;"><tr><td>1 Septic tank</td><td>6 Seepage pit</td><td><u>11</u> Fuel storage (former)</td><td>16 Other (specify below)</td></tr><tr><td>2 Sewer lines</td><td>7 Pit privy</td><td>12 Fertilizer storage</td><td></td></tr><tr><td>3 Watertight sewer lines</td><td>8 Sewage lagoon</td><td>13 Insecticide storage</td><td></td></tr><tr><td>4 Lateral lines</td><td>9 Feedyard</td><td>14 Abandoned water well</td><td></td></tr><tr><td>5 Cess Pool</td><td>10 Livestock pens</td><td>15 Oil well/ Gas well</td><td></td></tr></table> Direction from well? <u>Northwest</u> How many feet? <u>90</u>					1 Septic tank	6 Seepage pit	<u>11</u> Fuel storage (former)	16 Other (specify below)	2 Sewer lines	7 Pit privy	12 Fertilizer storage		3 Watertight sewer lines	8 Sewage lagoon	13 Insecticide storage		4 Lateral lines	9 Feedyard	14 Abandoned water well		5 Cess Pool	10 Livestock pens	15 Oil well/ Gas well													
1 Septic tank	6 Seepage pit	<u>11</u> Fuel storage (former)	16 Other (specify below)																																	
2 Sewer lines	7 Pit privy	12 Fertilizer storage																																		
3 Watertight sewer lines	8 Sewage lagoon	13 Insecticide storage																																		
4 Lateral lines	9 Feedyard	14 Abandoned water well																																		
5 Cess Pool	10 Livestock pens	15 Oil well/ Gas well																																		
<table border="1" style="width:100%; border-collapse: collapse;"><thead><tr><th>FROM</th><th>TO</th><th>CODE</th><th>PLUGGING MATERIALS</th></tr></thead><tbody><tr><td>0.0</td><td>3.0</td><td></td><td>Soils</td></tr><tr><td>3.0</td><td>20.0</td><td></td><td>Bentonite chips</td></tr><tr><td> </td><td> </td><td> </td><td> </td></tr><tr><td> </td><td> </td><td> </td><td> </td></tr><tr><td> </td><td> </td><td> </td><td> </td></tr><tr><td> </td><td> </td><td> </td><td> </td></tr><tr><td> </td><td> </td><td> </td><td> </td></tr></tbody></table>					FROM	TO	CODE	PLUGGING MATERIALS	0.0	3.0		Soils	3.0	20.0		Bentonite chips																				
FROM	TO	CODE	PLUGGING MATERIALS																																	
0.0	3.0		Soils																																	
3.0	20.0		Bentonite chips																																	
7 CONTRACTOR'S OR LANDOWNER'S CERTIFICATION: This water well was plugged under my jurisdiction and was completed on (mo/day/yr) <u>06/12/06</u> and this record is true to the best of my knowledge and belief. Kansas Water Well Contractor's License No. <u>692</u> This Water Well Record was completed on (mo/day/yr) <u>06/18/06</u> under the business name of <u>Quad State Services, Inc.</u> by (signature) 																																				
INSTRUCTIONS: Please fill in blanks and circle the correct answers. Send three copies to Kansas Department of Health and Environment, Bureau of Water, 1000 S W Jackson St., Ste. 420, Topeka, Kansas 66620-0001. Telephone: 785-296-3565. Send one to Water Well Owner and retain one for your records.																																				