


1	LOCATION OF WATER WELL:	Fraction	Section Number	Township Number	Range Number
County:	Reno	NE ¼ NE ¼ NE ¼	30	23S	05W

Distance and direction from nearest town or city street address of well if located within city?
2001 S. Lorraine, Hutchinson – SE corner of property

2	WATER WELL OWNER: Big M Truck Stop	Board of Agriculture, Division of Water Resources Application Number:
RR#, St. Address, Box # :	Rt 2, Box 98	
City, State, ZIP Code :	St. John, KS 67502	

3 MARK WELL'S LOCATION WITH AN "X" IN SECTION BOX:

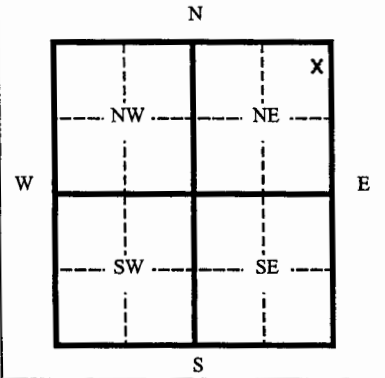

4	DEPTH OF WELL	13.35	ft.
	WELL'S STATIC WATER LEVEL	8.61	ft.
WELL WAS USED AS:			
1 Domestic	5 Public Water Supply	9 Dewatering	
2 Irrigation	6 Oil Field Water Supply	10 Monitoring Well	
3 Feedlot	7 Lawn and Garden (domestic)	11 Injection Well	
4 Industrial	8 Air Conditioning	12 Other	
Was a chemical/bacteriological sample submitted to Department?		Yes	No
If yes, mo/day/yr sample was submitted			
Water Well Disinfected:		Yes	No

5	TYPE OF BLANK CASING USED:			
1 Steel	3 RMP (SR)	5 Wrought	7 Fiberglass	9 Other (specify below)
2 PVC	4 ABC	6 Asbestos-Cement	8 Concrete Tile	
Blank casing diameter		2	in.	Was casing pulled? Yes No If yes, how much 13.35 ft
Casing height above or below land surface in.				

6	GROUT PLUG MATERIAL:	1 Neat cement	2 Cement grout	3 Bentonite	4 Other
Grout Plug Intervals From 13.35 ft. to 0.5 ft. From ft. to ft. From ft. to ft.					
What is the nearest source of possible contamination:					
1 Septic tank	6 Seepage pit	11 Fuel storage	16 Other (specify below)		
2 Sewer lines	7 Pit privy	12 Fertilizer storage			
3 Watertight sewer lines	8 Sewage lagoon	13 Insecticide storage			
4 Lateral lines	9 Feedyard	14 Abandoned water well			
5 Cess Pool	10 Livestock pens	15 Oil well/ Gas well			
Direction from well?		How many feet?			

FROM	TO	CODE	PLUGGING MATERIALS
0	0.5		Native Backfill
0.5	13.35		Bentonite 250 lbs.
			Overdrilled to 13.35 feet

7	CONTRACTOR'S OR LANDOWNER'S CERTIFICATION: This water well was plugged under my jurisdiction and was completed on (mo/day/yr) 8/10/06 and this record is true to the best of my knowledge and belief. Kansas Water Well Contractor's License No. 531 This Water Well Record was completed on (mo/day/yr) 8/11/06 under the business name of Geotechnical Services Inc. by (signature)	
---	---	--

INSTRUCTIONS: Please fill in blanks and circle the correct answers. Send three copies to Kansas Department of Health and Environment, Bureau of Water, 1000 S W Jackson St., Ste. 420, Topeka, Kansas 66620-0001. Telephone: 785-296-3565. Send one to Water Well Owner and retain one for your records.