

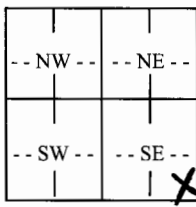
WATER WELL RECORD

Form WWC-5

Division of Water Resources; App. No.

46576

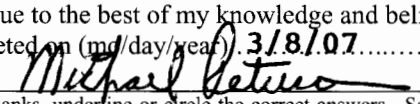
1 LOCATION OF WATER WELL:	Fraction	Section Number	Township Number	Range Number
County: Reno	SE ¼ SE ¼ SE ¼	23	T 23 S	R 5 X/W
Distance and direction from nearest town or city street address of well if located within city? 3 miles East of Hutchinson, Ks.		Global Positioning Systems (decimal degrees, min. of 4 digits)		
		Latitude: _____		
		Longitude: _____		
		Elevation: _____		
		Datum: _____		
		Data Collection Method: _____		

2 WATER WELL OWNER: Matt Brack RR#, St. Address, Box # : 4001 E. Ave. G City, State, ZIP Code : Hutchinson, Ks. 67501	3 LOCATE WELL'S LOCATION WITH AN "X" IN SECTION BOX: N W E S 	4 DEPTH OF COMPLETED WELL 36 ft. Depth(s) Groundwater Encountered (1)..... ft. (2)..... ft. (3)..... ft. WELL'S STATIC WATER LEVEL..... 9 ft. below land surface measured on mo/day/yr... 2/6/07 ... Pump test data: Well water was.....ft. after..... hours pumping..... gpm Est. Yield. 800 .gpm: Well water was.....ft. after..... hours pumping..... gpm WELL WATER TO BE USED AS: 5 Public water supply 8 Air conditioning 11 Injection well 1 Domestic 3 Feedlot 6 Oil field water supply 9 Dewatering 12 Other (Specify below) X Irrigation 4 Industrial 7 Domestic (lawn & garden) 10 Monitoring well Was a chemical/bacteriological sample submitted to Department? Yes No X; If yes, mo/day/yr Sample was submitted..... Water well disinfected? Yes X No
--	--	---

5 TYPE OF CASING USED:	5 Wrought Iron	8 Concrete tile	CASING JOINTS: Glued.. X Clamped.....
1 Steel	3 RMP (SR)	6 Asbestos-Cement	9 Other (specify below) Welded.....
X PVC	4 ABS	7 Fiberglass	Threaded.....
Blank casing diameter 1.0 in. to 1.6 ft., Diameter. in. to ft., Diameter in. to ft.			
Casing height above land surface..... 1.2 in., Weight..... 8.878 lbs./ft. Wall thickness or guage No. 413			
TYPE OF SCREEN OR PERFORATION MATERIAL:			
1 Steel	3 Stainless Steel	5 Fiberglass	X PVC
2 Brass	4 Galvanized Steel	6 Concrete tile	8 RM (SR)
		10 Asbestos-Cement	11 Other (Specify)
SCREEN OR PERFORATION OPENINGS ARE:			
1 Continuous slot	X Mill slot	5 Guazed wrapped	7 Torch cut
2 Louvered shutter	4 Key punched	6 Wire wrapped	8 Saw Cut
SCREEN-PERFORATED INTERVALS: From..... 1.6 ft. to 36 ft., From ft. to ft.			
GRAVEL PACK INTERVALS: From..... 1.6 ft. to 36 ft., From ft. to ft.			

6 GROUT MATERIAL:	1 Neat cement	2 Cement grout	X Bentonite	4 Other
Grout Intervals: From 0 ft. to 1.6 ft., From ft. to ft., From ft. to ft.				
What is the nearest source of possible contamination: None within 1/4 mile				
1 Septic tank	4 Lateral lines	7 Pit privy	10 Livestock pens	13 Insecticide Storage
2 Sewer lines	5 Cess pool	8 Sewage lagoon	11 Fuel storage	14 Abandoned water well
3 Watertight sewer lines	6 Seepage pit	9 Feedyard	12 Fertilizer Storage	15 Oil well/gas well
Direction from well? How many feet?				

FROM	TO	LITHOLOGIC LOG	FROM	TO	PLUGGING INTERVALS
0	2	Topsoil			
2	5	Clay, brown/sandy			
5	36	Sand, fine to coarse with small gravel			

7 CONTRACTOR'S OR LANDOWNER'S CERTIFICATION:	This water well was (X constructed, (2) reconstructed, or (3) plugged under my jurisdiction and was completed on (mo/day/year) 2/23/07 and this record is true to the best of my knowledge and belief.
Kansas Water Well Contractor's License No. 138	This Water Well Record was completed on (mo/day/year) 3/8/07
under the business name of Peterson Irrigation, Inc.	by (signature) 
INSTRUCTIONS: Use typewriter or ball point pen. PLEASE PRESS FIRMLY and PRINT clearly. Please fill in blanks, underline or circle the correct answers. Send top three copies to Kansas Department of Health and Environment, Bureau of Water, Geology Section, 1000 SW Jackson St., Suite 420, Topeka, Kansas 66612-1367. Telephone 785-296-5522. Send one to WATER WELL OWNER and retain one for your records. Fee of \$5.00 for each constructed well. Visit us at http://www.kdhe.state.ks.us/geo/waterwells .	