


1	LOCATION OF WATER WELL:	Fraction	Section	Number	Township	Number	Range	Number
	County: Reno	NW ¼ NE ¼ NE ¼	18		23		5	E(W)

Distance and direction from nearest town or city street address of well if located within city?
1215 E. 4th Ave., Hutchinson

2 WATER WELL OWNER: DENNIS DICK
RR #, St. Address, Box #: 1215 E. 4TH AVENUE Board of Agriculture, Division of Water Resources
City, State, ZIP Code : HUTCHINSON, KS 67501 Application Number:

3	MARK WELL'S LOCATION WITH AN "X" IN SECTION BOX:	4	DEPTH OF WELL25..... ft. WELL'S STATIC WATER LEVELN/A..... ft. WELL WAS USED AS: 1 Domestic 5 Public Water Supply 9 Dewatering 2 Irrigation 6 Oil Field Water Supply ● Monitoring Well 3 Feedlot 7 Domestic (Lawn & Garden) 11 Injection Well 4 Industrial 8 Air Conditioning 12 Other
---	--	---	--

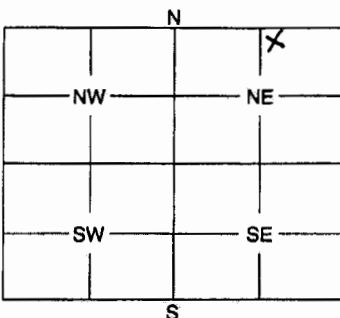

Was a chemical / bacteriological sample submitted to Department? Yes No
If yes, mo/day/yr sample was submitted

Water Well Disinfected: Yes No

5 TYPE OF BLANK CASING USED:
1 Steel 3 RMP (SR) 5 Wrought 7 Fiberglass 9 Other (Specify below)
● PVC 4 ABS 6 Asbestos-Cement 8 Concrete Tile

Blank casing diameter2..... in. Was casing pulled? Yes No If yes, how much3'.....
Casing height above or below land surface0..... in.

6 GROUT PLUG MATERIAL: 1 Neat cement 2 Cement grout ● Bentonite ● Other ..Concrete and Native Soil.....
Grout Plug Intervals: From0..... ft. to1..... ft., From1..... ft. to3..... ft., From3..... to25..... ft.

What is the nearest source of possible contamination:
1 Septic tank 6 Seepage pit 11 Fuel storage 16 Other (specify below)
2 Sewer lines 7 Pit privy 12 Fertilizer storage ..
3 Watertight sewer lines 8 Sewage lagoon 13 Insecticide storage ..
4 Lateral lines 9 Feedyard 14 Abandoned water well ..
5 Cess pool 10 Livestock pens 15 Oil well/Gas well ..

Direction from well? How many feet?

FROM	TO	PLUGGING MATERIALS
0	1	Concrete
1	3	Native soil
3	25	Bentonite

MW1
GeoCore #984
KDHE #U2 078 10885

7 CONTRACTOR'S OF LANDOWNER'S CERTIFICATION: This water well was plugged under my jurisdiction and was completed on (mo/day/year)3/1/2007..... and this record is true to the best of my knowledge and belief. Kansas Water Well Contractor's License No.527..... This Water Well Record was completed on (mo/day/year)3/19/2007..... under the business name of, Geocore, Inc.
by (signature) Dale [Signature]

INSTRUCTIONS: Use typewriter or ball point pen. Please press firmly and print clearly. Please fill in blanks, underline or circle the correct answers. Send top three copies to Kansas Department of Health and Environment, Bureau of Water, Geology Section, 1000 SW Jackson St., Ste. 420, Topeka, Kansas 66612-1367. Telephone: 785/296-5522. Send one to Water Well Owner and retain one for your records.