

WATER WELL PLUGGING RECORD

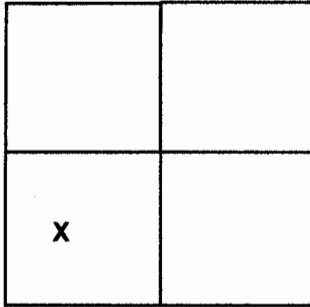
Form WWC-5P

KSA 82a-1212

FSW

LOCATION OF WATER WELL:	Fraction	Section Number	Township Number	Range Number
Reno	SE 1/4 NW 1/4 SW 1/4	09	23 SOUTH	05 WEST

Distance and direction from nearest town or city street address of well if located within city?

APPROXIMATELY 1474' North and 902' East of the intersection of 4th Avenue and Halstead Street, Hutchinson, KSWATER WELL OWNER: **City of Hutchinson**RR#, St. Address, Box #: **1500 S. Plum**
City, State, ZIP Code: **Hutchinson, KS 67501**Board of Agriculture, Division of Water Resources
Application Number: **N/A**MARK WELL'S LOCATION WITH
AN "X" IN SECTION BOX
N

S

DEPTH OF WELL **10.0** ft.WELL'S STATIC WATER LEVEL **N/A** – Water level below total well depth

WELL WAS USED AS:

- | | | |
|--------------|--------------------------|----------------------------------|
| 1 Domestic | 5 Public Water Supply | 9 Dewatering |
| 2 Irrigation | 6 Oil Field Water Supply | 10 Monitoring Well SVE-S1 |
| 3 Feedlot | 7 Lawn and Garden Only | 11 Injection Well |
| 4 Industrial | 8 Air Conditioning | 12 Other |

Was a chemical/bacteriological sample submitted to Department? Yes ☐ No ☒
If yes, mo/day/yr sample was submitted : / /WaterWell Disinfected: Yes ☒ No ☐

TYPE OF BLANK CASING USED:

- | | | | | |
|--------------|------------|-------------------|-----------------|--------------|
| 1 Steel | 3 RMP (SR) | 5 Wrought | 7 Fiberglass | 9 Other ____ |
| 2 PVC | 4 ABS | 6 Asbestos-Cement | 8 Concrete Tile | |

Blank casing diameter **2.0** in. Was casing pulled? Yes ☒ No ☐ if yes, how much **ALL**
Casing height above or below land surface **N/A** feet.GROUT PLUG MATERIAL: 1 Neat cement 2 Cement grout **3 Bentonite** 4 OtherGrout Plug Intervals: From **10.0** ft. to **3.0** ft.

What is the nearest source of possible contamination:

- | | | | |
|--------------------------|-------------------|-------------------------|-----------------------------------|
| 1 Septic tank | 6 Seepage pit | 11 Fuel Storage | 16 Other – Grain Elevator, |
| 2 Sewer lines | 7 Pit privy | 12 Fertilizer storage | carbon tetrachloride |
| 3 Watertight sewer lines | 8 Sewage lagoon | 13 Insecticide storage | groundwater |
| 4 Lateral lines | 9 Feedyard | 14 Abandoned water well | remediation project |
| 5 Cess Pool | 10 Livestock pens | 15 Oil well / Gas well | |

Direction from well? **On-site** How many feet? **0**

FROM	TO	PLUGGING MATERIALS
10.0	3.0	Bentonite Hole Plug
3.0	0	Topsoil

CONTRACTOR'S OR LANDOWNER'S CERTIFICATION: This water well was plugged under my jurisdiction and was completed on (mo/day/year) **03 / 14 / 2007** and this record is true to the best of my knowledge and belief. Kansas Water Well Contractor's License No. **N/A** This Water Well Record was completed on (mo/day/year) **04 / 10 / 2007** under the business name of **City of Hutchinson** by (signature) *[Signature]*, Licensed Geologist

INSTRUCTIONS: Use typewriter or ball point pen. Please press firmly and print clearly. Please fill in blanks, and underline or circle the correct answers. Send top three copies to Kansas Department of Health and Environment, Bureau of Water, Topeka, Kansas 66620-0001. Telephone: 913/296-3565. Send one to Water Well Owner and retain one for your records.