WATER WELL PLUGGING RECORD Form WWC-5P KSA 82a-1 212 ID NO

1 LOCATION OF WATER WELL:	Fraction	Section Number	Township Number	Range Number
County: Reno	SE 1/4 SW 1/4 NW 1/4	17	23	5 E/W

Distance and direction from nearest town or city street address of well if located within city?
Reno County Landfill, Carey Blvd., Hutchinson, KS

2 WATER WELL OWNER: IMC Salt, Inc.
RR #, St. Address, Box #: 1800 Carey Blvd.
City, State, ZIP Code: Hutchinson, KS 67501
Board of Agriculture, Division of Water Resources Application Number:

3 **MARK** WELL'S LOCATION WITH AN "X" IN SECTION BOX:

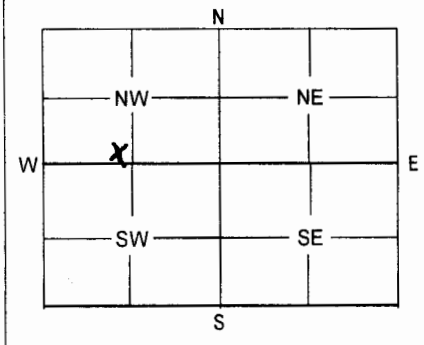

4 DEPTH OF WELL 54 ft.
WELL'S STATIC WATER LEVEL 14.3 ft.
WELL WAS USED AS:

1 Domestic	5 Public Water Supply	9 Dewatering
2 Irrigation	6 Oil Field Water Supply	10 Monitoring Well
3 Feedlot	7 Domestic (Lawn & Garden)	11 Injection Well
(4) Industrial	8 Air Conditioning	12 Other

Was a chemical / bacteriological sample submitted to Department? Yes ..... No X
if yes, mo/day/yr sample was submitted .....
Water Well Disinfected: Yes X No .....

5 TYPE OF BLANK CASING USED:

1 Steel	3 RMP (SR)	5 Wrought	7 Fiberglass	9 Other (Specify below)
(2) PVC	4 ABS	6 Asbestos-Cement	8 Concrete Tile	

Blank casing diameter 15 in. Was casing pulled? Yes ..... No X If yes, how much 3'
Casing height above or below land surface 36" below in.

6 GROUT PLUG MATERIAL: 1 Neat cement 2 Cement grout (3) Bentonite 4 Other .....
Grout Plug Intervals: From 14.3 ft. to 3 ft., From ..... ft. to ..... ft., From ..... to ..... ft

What is the nearest source of possible contamination:

1 Septic tank	6 Seepage pit	11 Fuel storage	(16) Other (specify below)
2 Sewer lines	7 Pit privy	12 Fertilizer storage	Salt Storage Plant
3 Watertight sewer lines	8 Sewage lagoon	13 Insecticide storage	
4 Lateral lines	9 Feedyard	14 Abandoned water well	
5 Cess pool	10 Livestock pens	15 Oil well/Gas well	

Direction from well? Immediate vicinity How many feet? Immediate vicinity

FROM	TO	PLUGGING MATERIALS
54	14.3	Sand and gravel
14.3	3	3/8 Bentonite chips
3	0	Topsoil
		#35

7 CONTRACTOR'S OF LANDOWNER'S CERTIFICATION: This water well was plugged under my jurisdiction and was completed on (mo/day/year) 5-22-07 and this record is true to the best of my knowledge and belief. Kansas Water Well Contractor's License No. 665 This Water Well Record was completed on (mo/day/year) 6-12-07 under the business name of Pratt Well Environmental
by (signature) Jason E. Gill

INSTRUCTIONS: Use typewriter or ball point pen. Please press firmly and print clearly. Please fill in blanks, underline or circle the correct answers. Send top three copies to Kansas Department of Health and Environment, Bureau of Water, Geology Section, 1 000 SW Jackson St., Ste. 420, Topeka, Kansas 66612-1367. Telephone: 785/296-5522. Send one to Water Well Owner and retain one for your records.