


4<sup>th</sup> and Airport Rd., Hutchinson

Board of Agriculture, Division of Water Resources

Application Number:

4	DEPTH OF COMPLETED WELL	17	ft. ELEVATION:	1503.70 (TOC)
---	-------------------------	----	----------------	---------------

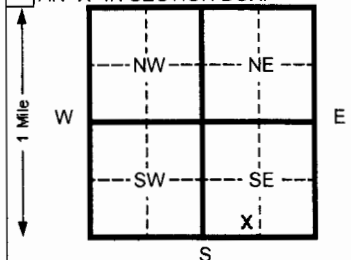

2 Irrigation    4 Industrial    7 Lawn and garden (domestic)    **10 Monitoring well** .....

submitted Water Well Disinfected? Yes No **X**

TYPE OF SCREEN OR PERFORATION MATERIAL: 7 PVC 10 Asbestos-cement

SCREEN-PERFORATED INTERVALS: From 7 ft. to 17 ft. From \_\_\_\_\_ ft. to \_\_\_\_\_ ft.

	From	ft. to	ft.	From	ft. to	ft.

What is the nearest source of possible contamination:	10 Livestock pens	14 Abandoned water well
---	-------------------	-------------------------

3 Watertight sewer lines	6 Seepage pit	9 Feedyard	13 Insecticide storage	.....
--------------------------	---------------	------------	------------------------	-------

FROM	TO	CODE	LITHOLOGIC LOG	FROM	TO	PLUGGING INTERVALS
			Clay, dark brown to light brown, silty			

			Sand, light brown, very fine to coarse		
--	--	--	--	--	--

--	--	--	--	--	--	--

[illegible][illegible][illegible]

7 CONTRACTOR'S OR LANDOWNER'S CERTIFICATION: This water well was (1) constructed, (2) reconstructed, or (3) plugged under my jurisdiction and was

Water Well Contractor's License No. **531** This Water Well Record was completed on (mo/day/yr) **06/19/08**


Jackson St., Ste. 420, Topeka, Kansas 66612-1367. Telephone: 913-296-5545. Send one to WATER WELL OWNER and retain one for your records.