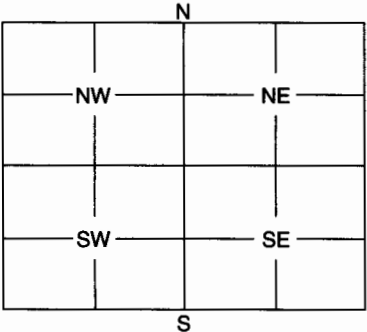


|   |                         |  |           |        |            |        |          |        |
|---|-------------------------|--|-----------|--------|------------|--------|----------|--------|
| 1 | LOCATION OF WATER WELL: | Fraction                                     | Section   | Number | Township   | Number | Range    | Number |
|   | County: <u>Reno</u>     | $\frac{1}{4}$ $\frac{1}{4}$ NE $\frac{1}{4}$ | <u>17</u> |        | <u>23S</u> |        | <u>5</u> | EW     |

Distance and direction from nearest town or city street address of well if located within city?

475 ft South of Sherman & 300 ft West of Town

|   |  |   |
|---|--|---|
| 2 | WATER WELL OWNER: <u>ADM Grain</u>                 | Board of Agriculture, Division of Water Resources |
|   | RR #, St. Address, Box #: <u>816 N. Halstead</u>   | Application Number:                               |
|   | City, State, ZIP Code: <u>Hutchinson, KS 67501</u> |   |

|   |  |   |  |
|---|--|---|--|
| 3 | MARK WELL'S LOCATION WITH AN "X" IN SECTION BOX:                                 | 4 | DEPTH OF WELL <u>58</u> ft.  |
|   |  |   | WELL'S STATIC WATER LEVEL <u>11.5</u> ft.  |
|   |  |   | WELL WAS USED AS:  |
|   |  |   | 1 Domestic<br>2 Irrigation<br>3 Feedlot<br>4 Industrial<br>5 Public Water Supply<br>6 Oil Field Water Supply<br>7 Domestic (Lawn & Garden)<br>8 Air Conditioning<br>9 Dewatering<br>10 <input checked="" type="radio"/> Monitoring Well<br>11 Injection Well<br>12 Other ..... |
|   |  |   | Was a chemical / bacteriological sample submitted to Department? Yes <u>X</u> No <u>X</u>  |
|   |  |   | If yes, mo/day/yr sample was submitted .....   |
|   |  |   | Water Well Disinfected: Yes ..... No <u>X</u>  |

|   |  |
|---|--|
| 5 | TYPE OF BLANK CASING USED:   |
|   | 1 Steel<br>2 <input checked="" type="radio"/> PVC<br>3 RMP (SR)<br>4 ABS<br>5 Wrought<br>6 Asbestos-Cement<br>7 Fiberglass<br>8 Concrete Tile<br>9 Other (Specify below) ..... |
|   | Blank casing diameter ..... in. Was casing pulled? Yes <u>X</u> No ..... If yes, how much <u>20 ft</u>   |
|   | Casing height above or below land surface ..... in.  |

|   |  |  |   |  |               |
|---|--|--|---|--|---------------|
| 6 | GROUT PLUG MATERIAL:   | 1 Neat cement  | 2 Cement grout  | 3 <input checked="" type="radio"/> Bentonite | 4 Other ..... |
|   | Grout Plug Intervals:  | From <u>1</u> ft.  | to <u>58</u> ft.  | From ..... ft.                               | to ..... ft.  |
|   | What is the nearest source of possible contamination:  |  |   |  |               |
|   | 1 Septic tank<br>2 Sewer lines<br>3 Watertight sewer lines<br>4 Lateral lines<br>5 Cess pool | 6 Seepage pit<br>7 Pit privy<br>8 Sewage lagoon<br>9 Feedyard<br>10 Livestock pens | 11 Fuel storage<br>12 Fertilizer storage<br>13 Insecticide storage<br>14 Abandoned water well<br>15 Oil well/Gas well | 16 Other (specify below) .....               |               |
|   | Direction from well? ..... How many feet? .....  |  |   |  |               |

| FROM     | TO        | PLUGGING MATERIALS |
|----------|-----------|--------------------|
| <u>0</u> | <u>1</u>  | <u>Top Soil</u>    |
| <u>1</u> | <u>58</u> | <u>Bentonite</u>   |
|          |           |                    |
|          |           |                    |
|   |   |
|---|---|
| 7 | CONTRACTOR'S OR LANDOWNER'S CERTIFICATION: This water well was plugged under my jurisdiction and was completed on (mo/day/year) <u>10/1/08</u> and this record is true to the best of my knowledge and belief. Kansas Water Well Contractor's License No. <u>604</u> This Water Well Record was completed on (mo/day/year) ..... under the business name of <u>Environmental Priority Service, Inc.</u> |
|   | by (signature) <u>[Signature]</u>   |

INSTRUCTIONS: Use typewriter or ball point pen. Please press firmly and print clearly. Please fill in blanks, underline or circle the correct answers. Send top three copies to Kansas Department of Health and Environment, Bureau of Water, Geology Section, 1000 SW Jackson St., Ste. 420, Topeka, Kansas 66612-1367. Telephone: 785/296-5522. Send one to Water Well Owner and retain one for your records.